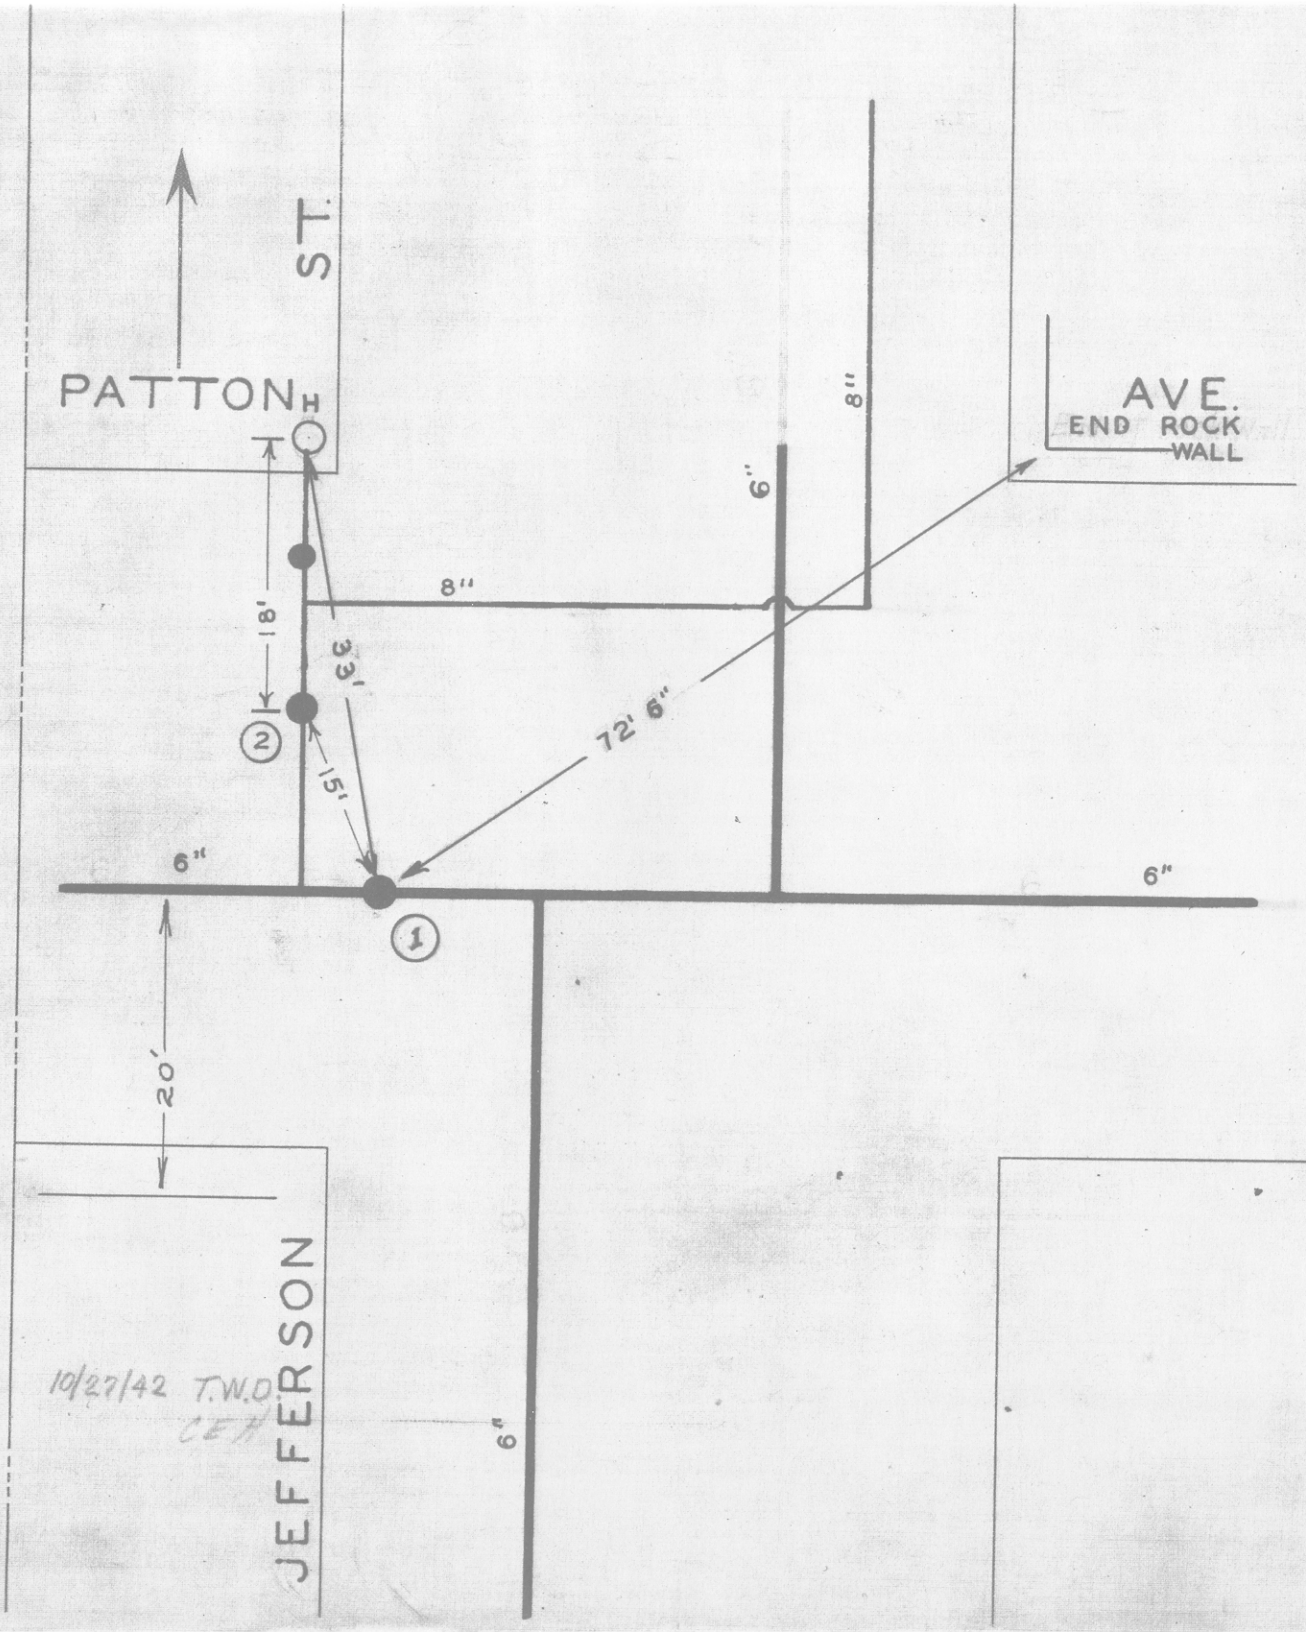

DATE	NO.	SIZE	MAKE	OPEN	TURNS
1891	1	6		R	19 1/2
7-61	2	6"	DARLING	R	
	1	0	WPL		
	2	2'W.	W.P.L.		

CITY OF ROANOKE—WATER DEP'T

VALVE DIAGRAM

JEFFERSON ST. & PATTON AVE. N.W. OR N.E. copy in put in

SEC. MAP 201

DATE PAGE NO. N.W.23.