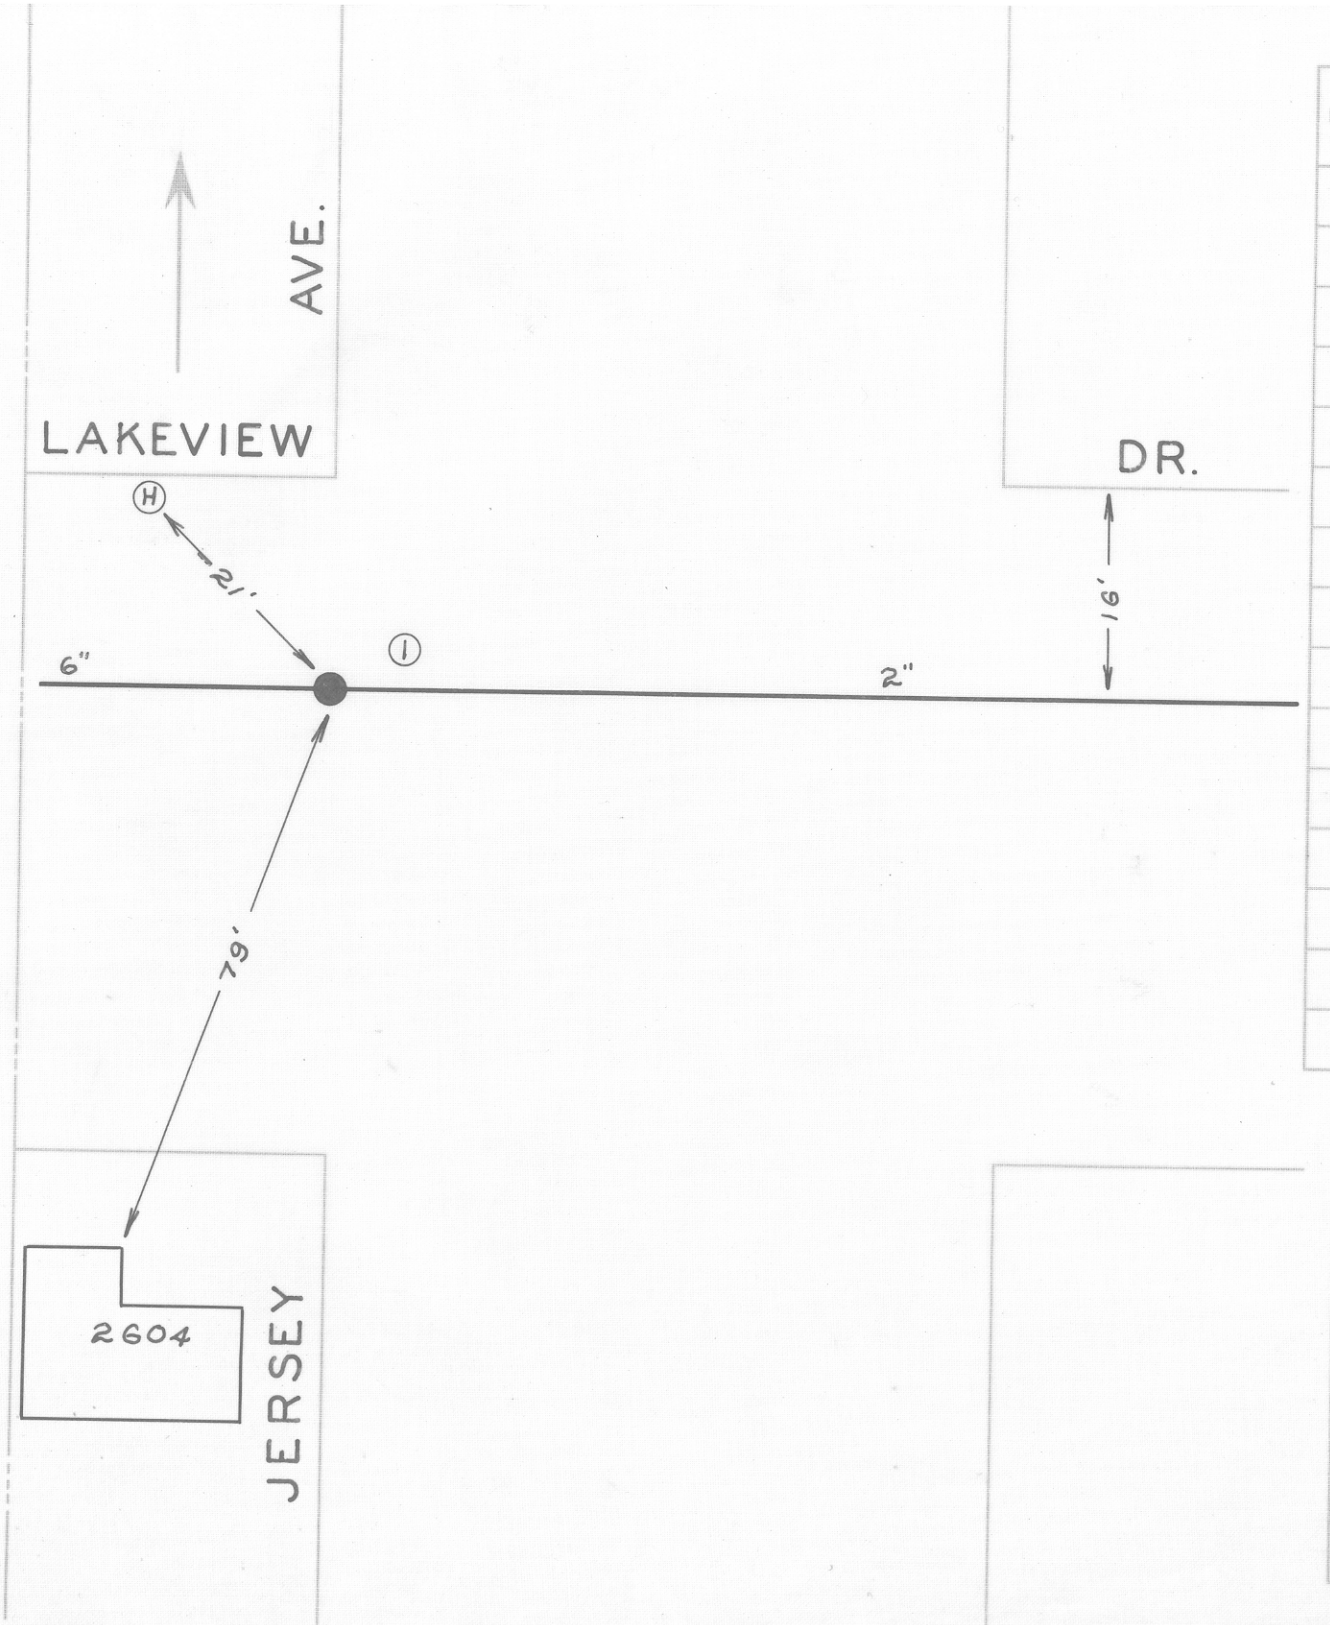


| DATE | NO. | SIZE | MAKE | OPEN | TURNS |
|---|---|---|---|---|---|
| | 1 | 2" | DARLING | R | 7 |
| | 1 | 0 | WPL | | |

CITY OF ROANOKE—WATER DEP'T

VALVE DIAGRAM

JERSEY AVE. &

LAKEVIEW DR. N.W.

SEC. MAP 247

DATE PAGE NO.