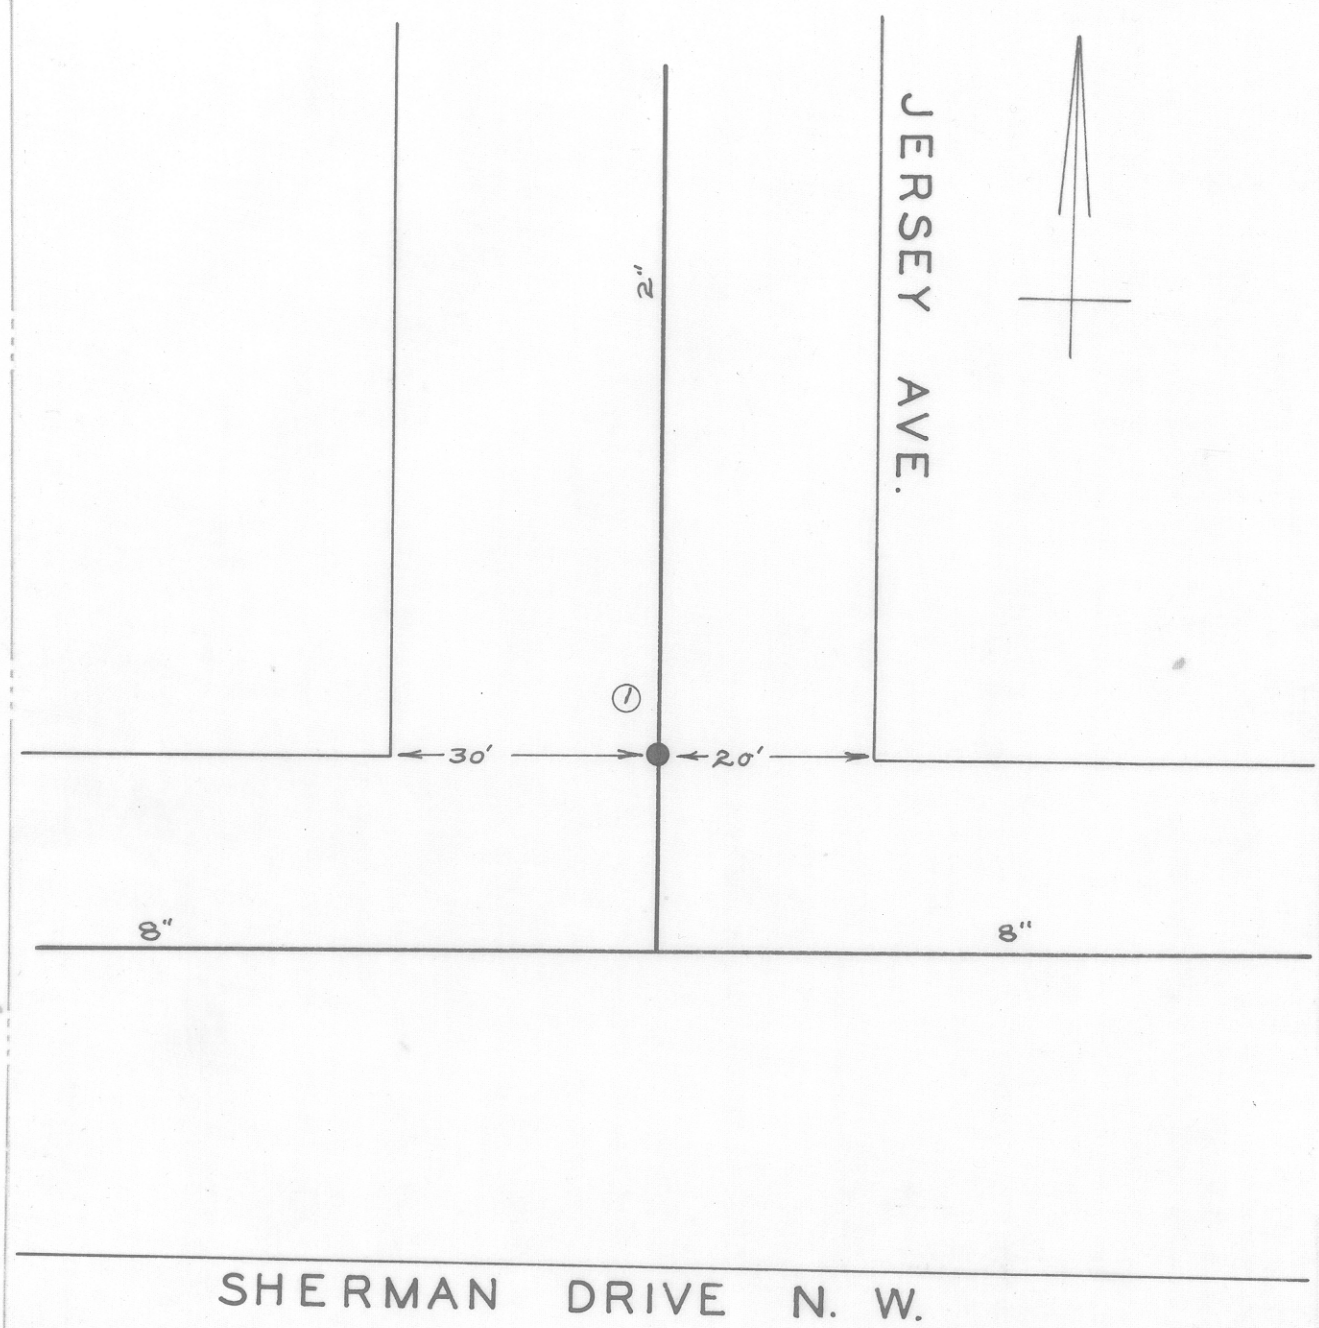

DATE	NO.	SIZE	MAKE	OPEN	TURNS
	1	2"	DARLING	R	7
	1	0	NPL		

CITY OF ROANOKE — WATER DEPT.

VALVE DIAGRAM

JERSEY AVE. & SHERMAN DRIVE N. W.

SEC. MAP 247

DATE PAGE NO.

"IMPERIAL" TRACING CLOTH. K & E CO., N. Y.