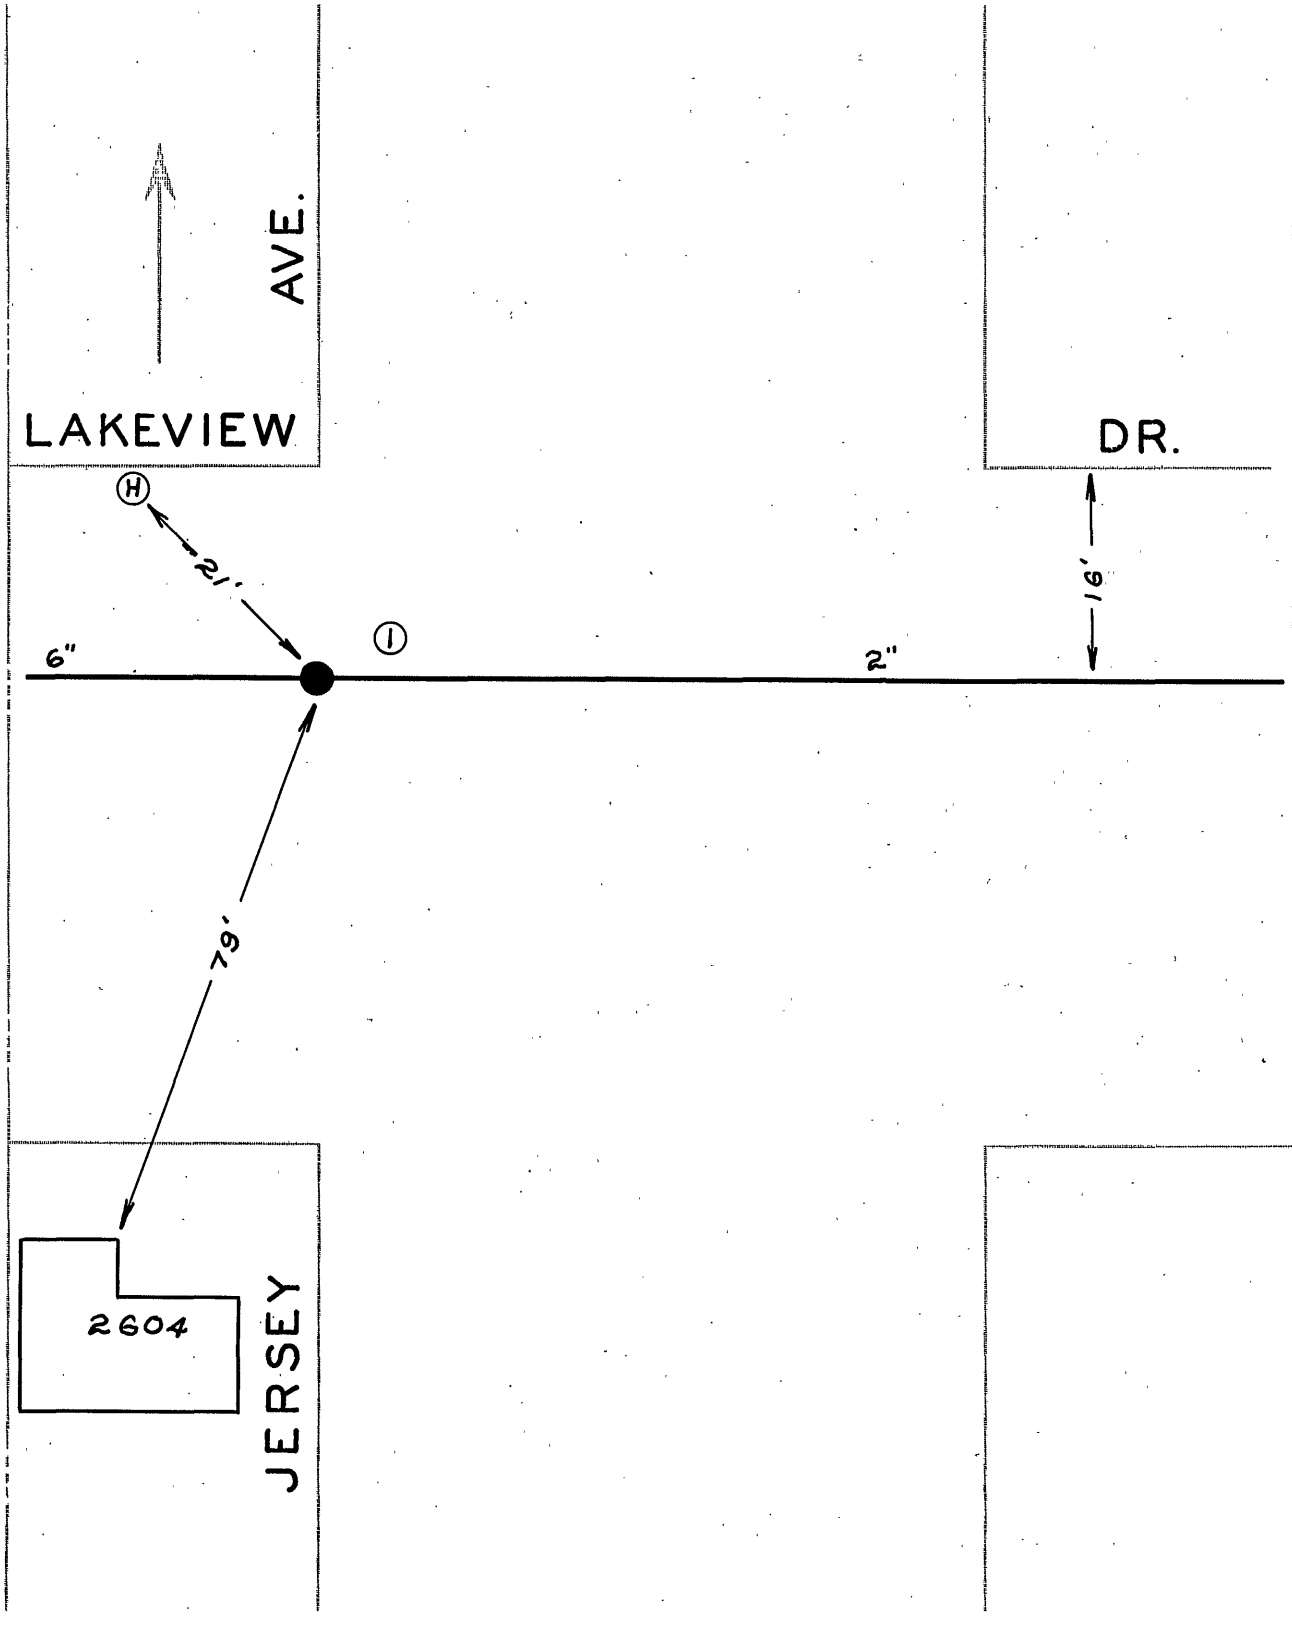

DATE	NO.	SIZE	MAKE	OPEN	TURNS
	1	2"	DARLING	R	7
	1	0	WPL		

CITY OF ROANOKE—WATER DEP'T

VALVE DIAGRAM

JERSEY AVE. &

LAKEVIEW DR. N.W.

SEC. MAP 247

DATE PAGE NO.