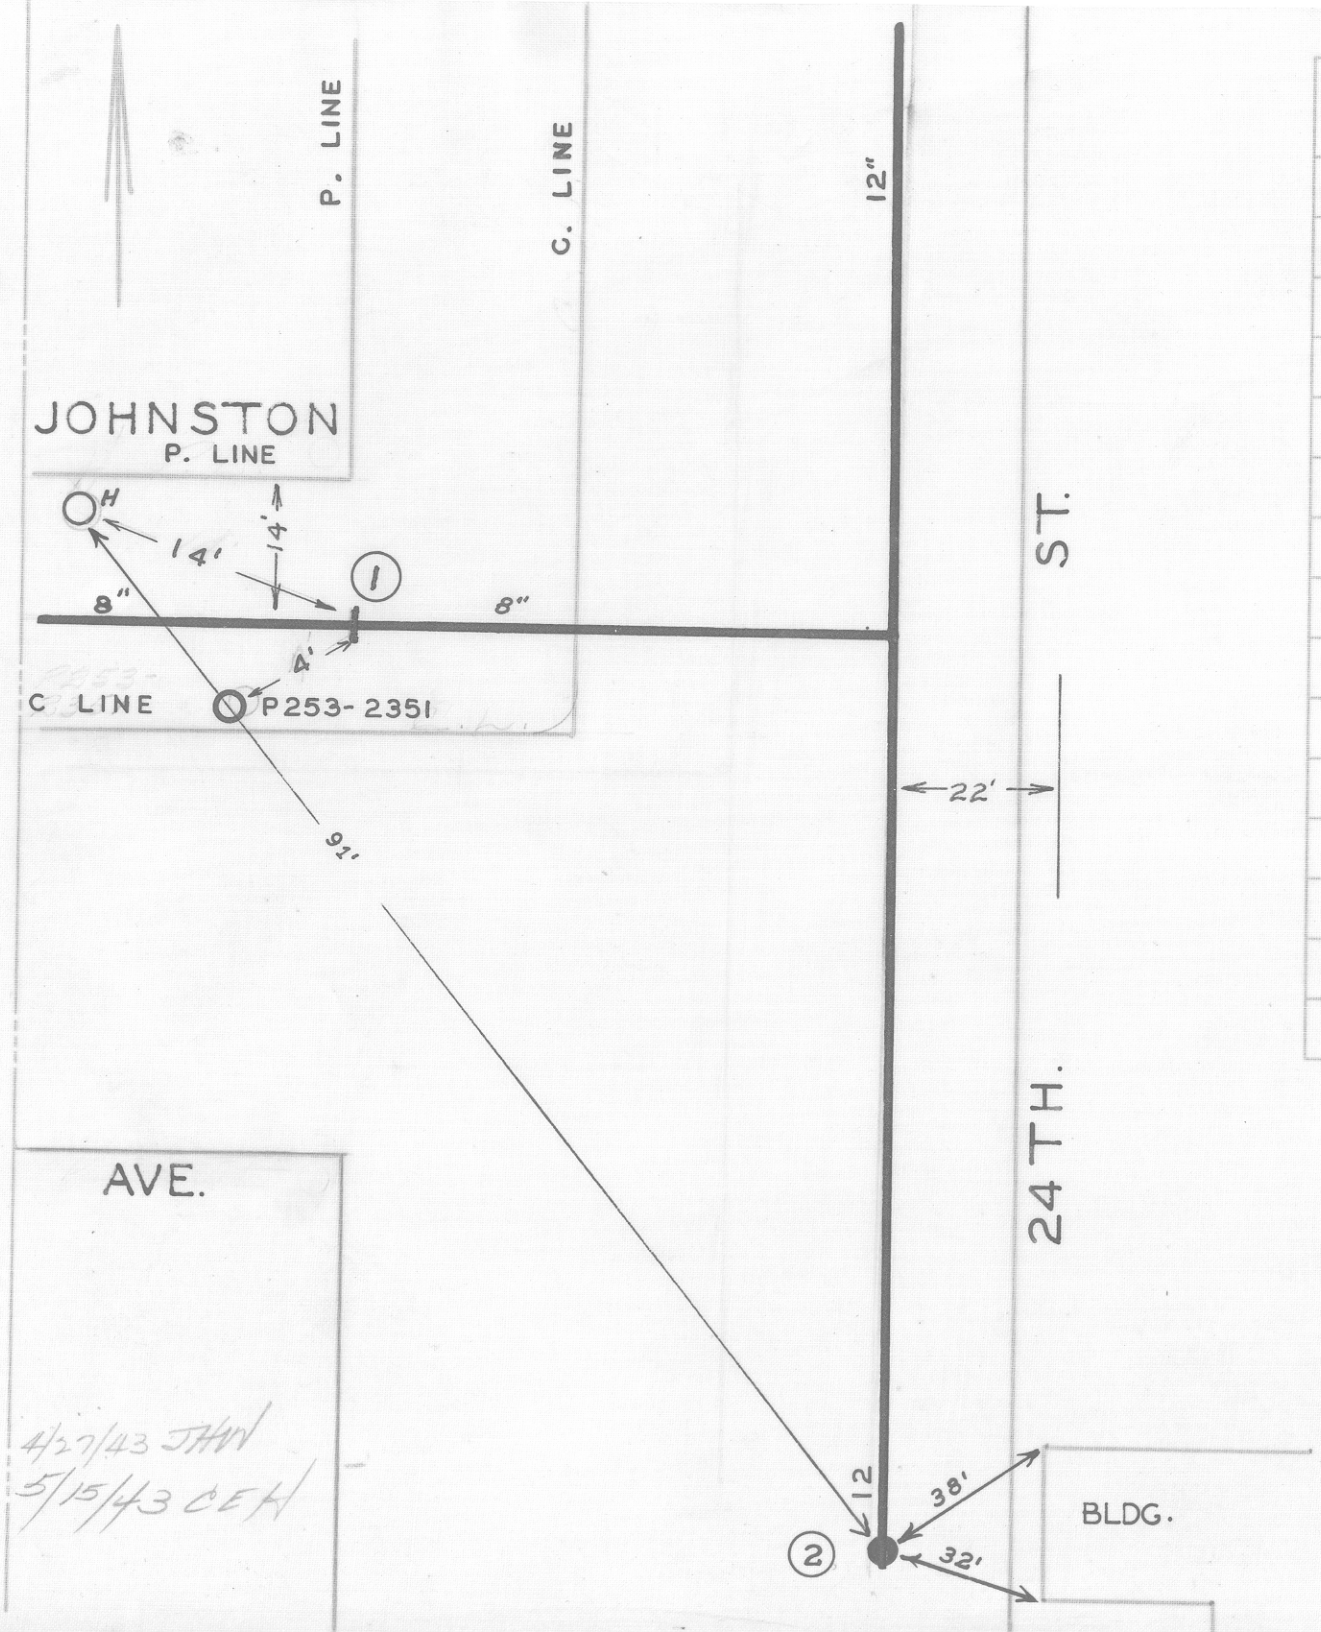


| DATE | NO. | SIZE | MAKE | OPEN | TURNS |
|---|---|---|---|---|---|
| 1937 | 1 | 8" | | R | 27 |
| 1952 | 2 | 12" | DARLING | R | 39 |
| | | | | | |
| | | | | | |
| | 1 | 0 | WPL | | |
| | 2 | 40'-S | SPL | | |
| | | | | | |

CITY OF ROANOKE.—WATER DEP'T

VALVE DIAGRAM

JOHNSTON AVE. & 24TH. ST. N.W.

SEC. MAP 231

DATE

PAGE NO. NW. 187