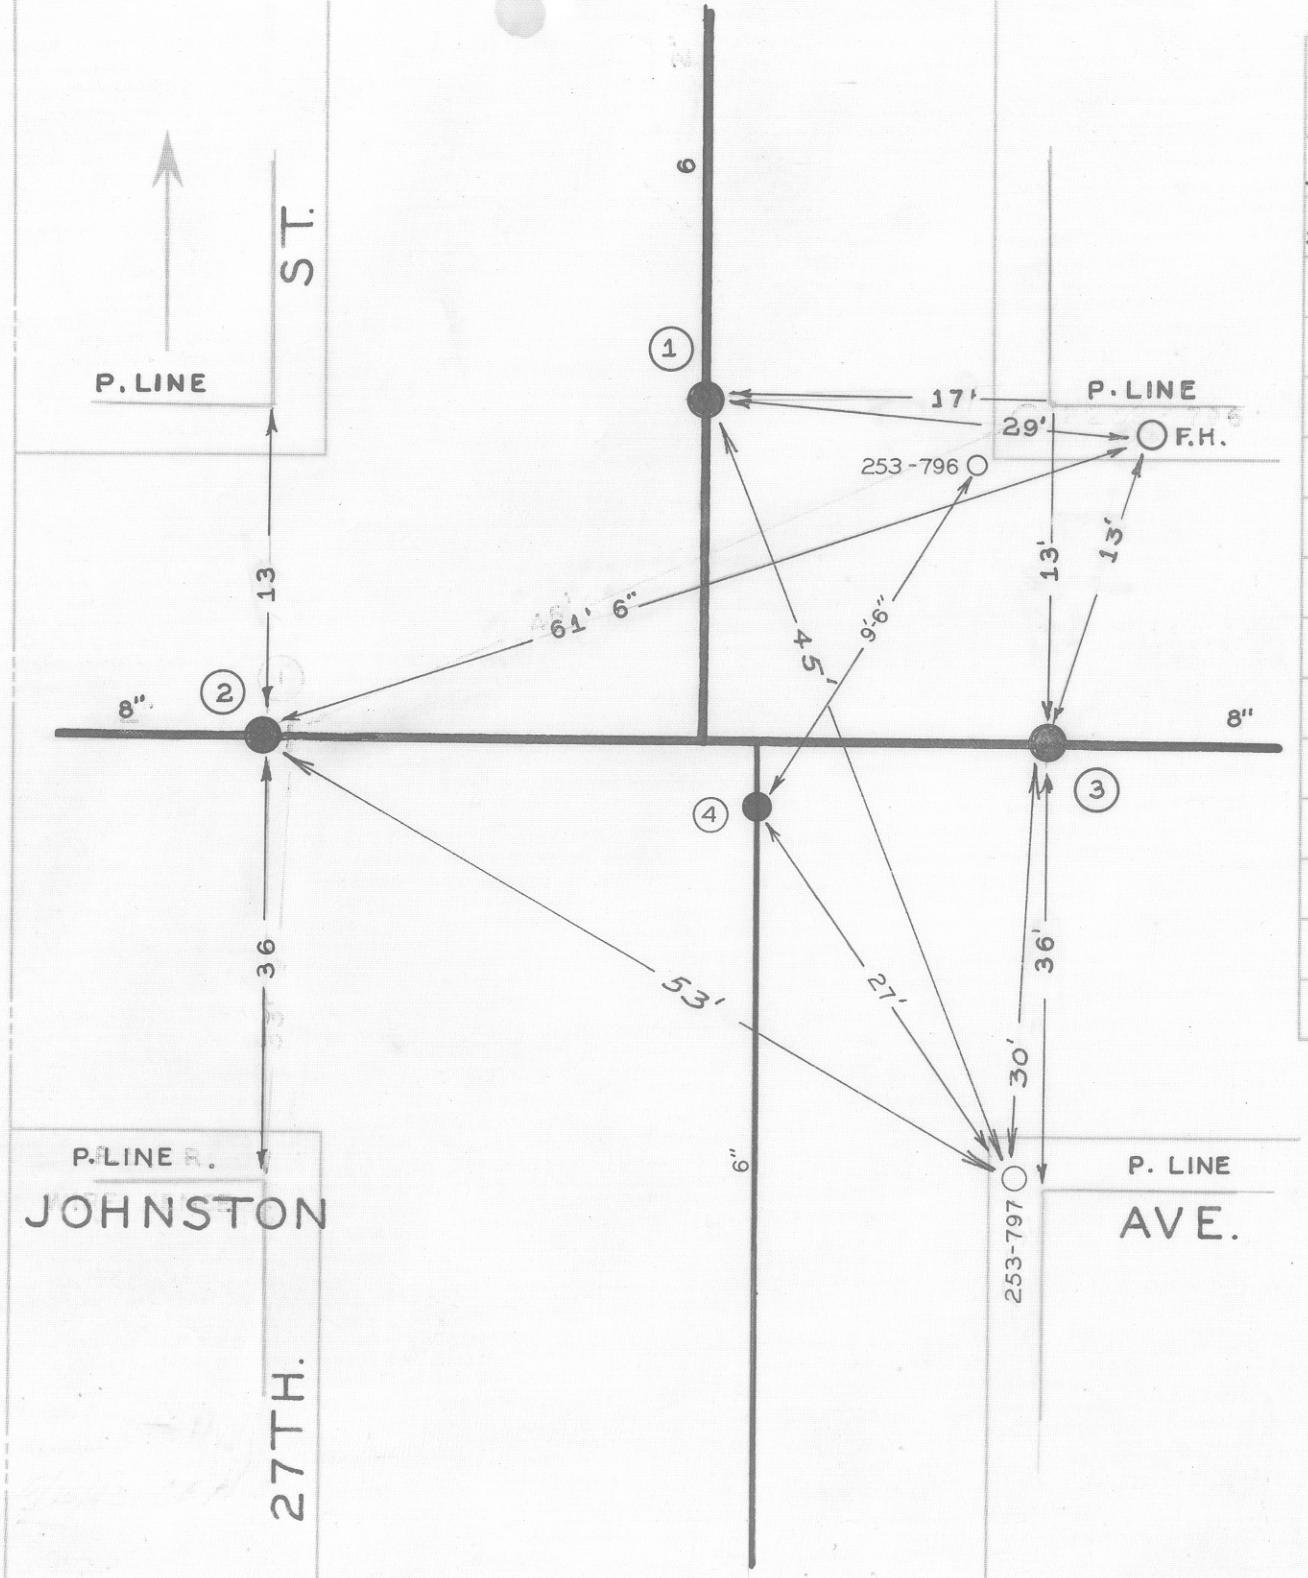

DATE	NO.	SIZE	MAKE	OPEN	TURNS
1951	1	6"	DARLING	R	21
1951	2	8"	DARLING	R	27
1951	3	8"	DARLING	R	27
72	4	6"	DARLING	R	
	1	0	NPL		
	2	0	WPL		
	3	0	EPL		

CITY OF ROANOKE—WATER DEP'T

VALVE DIAGRAM

JOHNSTON AVE. & 27TH.

N.W.

SEC. MAP 241

DATE

PAGE NO. NW238