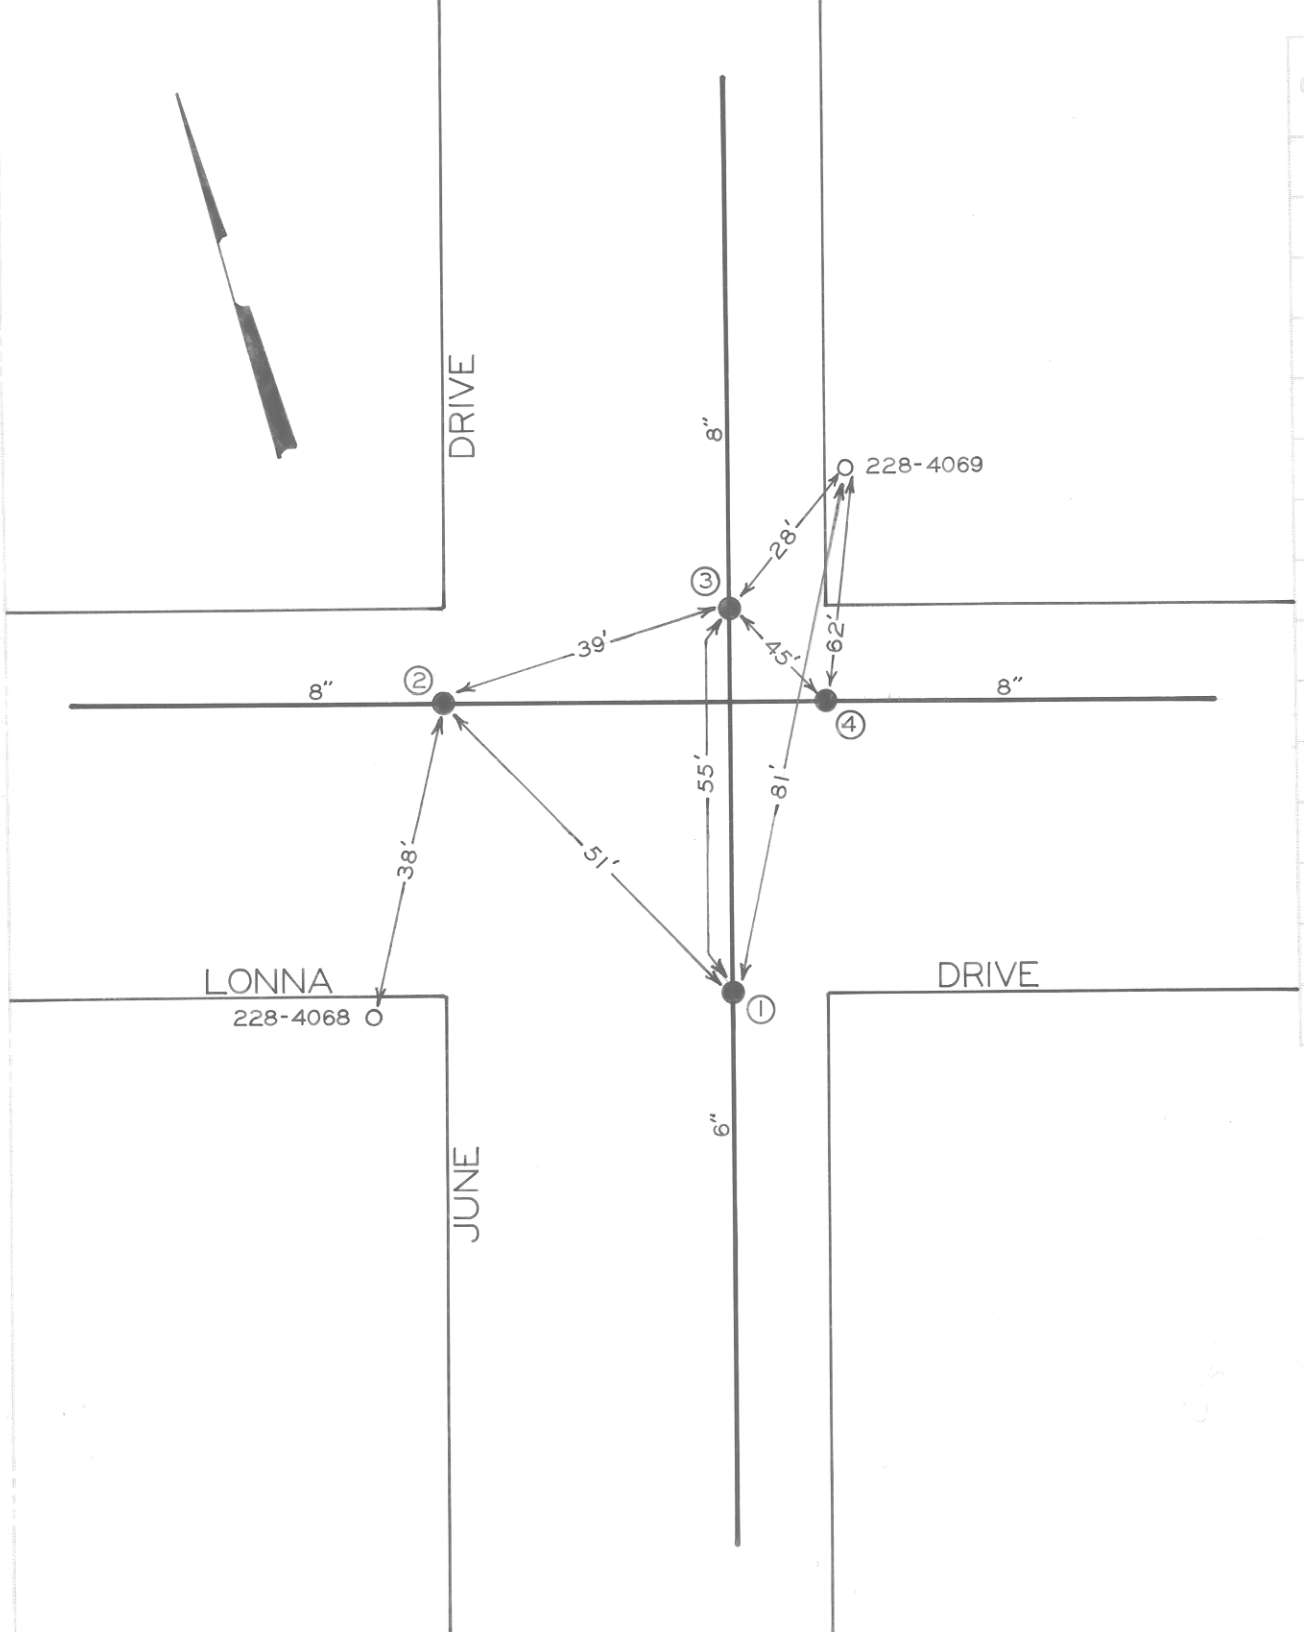

DATE	NO.	SIZE	MAKE	OPEN	TURNS
71	1	6"	MUELLER	R	21
71	2	8"	MUELLER	R	27
71	3	8"	MUELLER	R	27
71	4	8"	MUELLER	R	27

CITY OF ROANOKE—WATER DEP'T

VALVE DIAGRAM

JUNE DRIVE &

LONNA DRIVE N.W.

SEC. MAP 44

DATE PAGE NO.