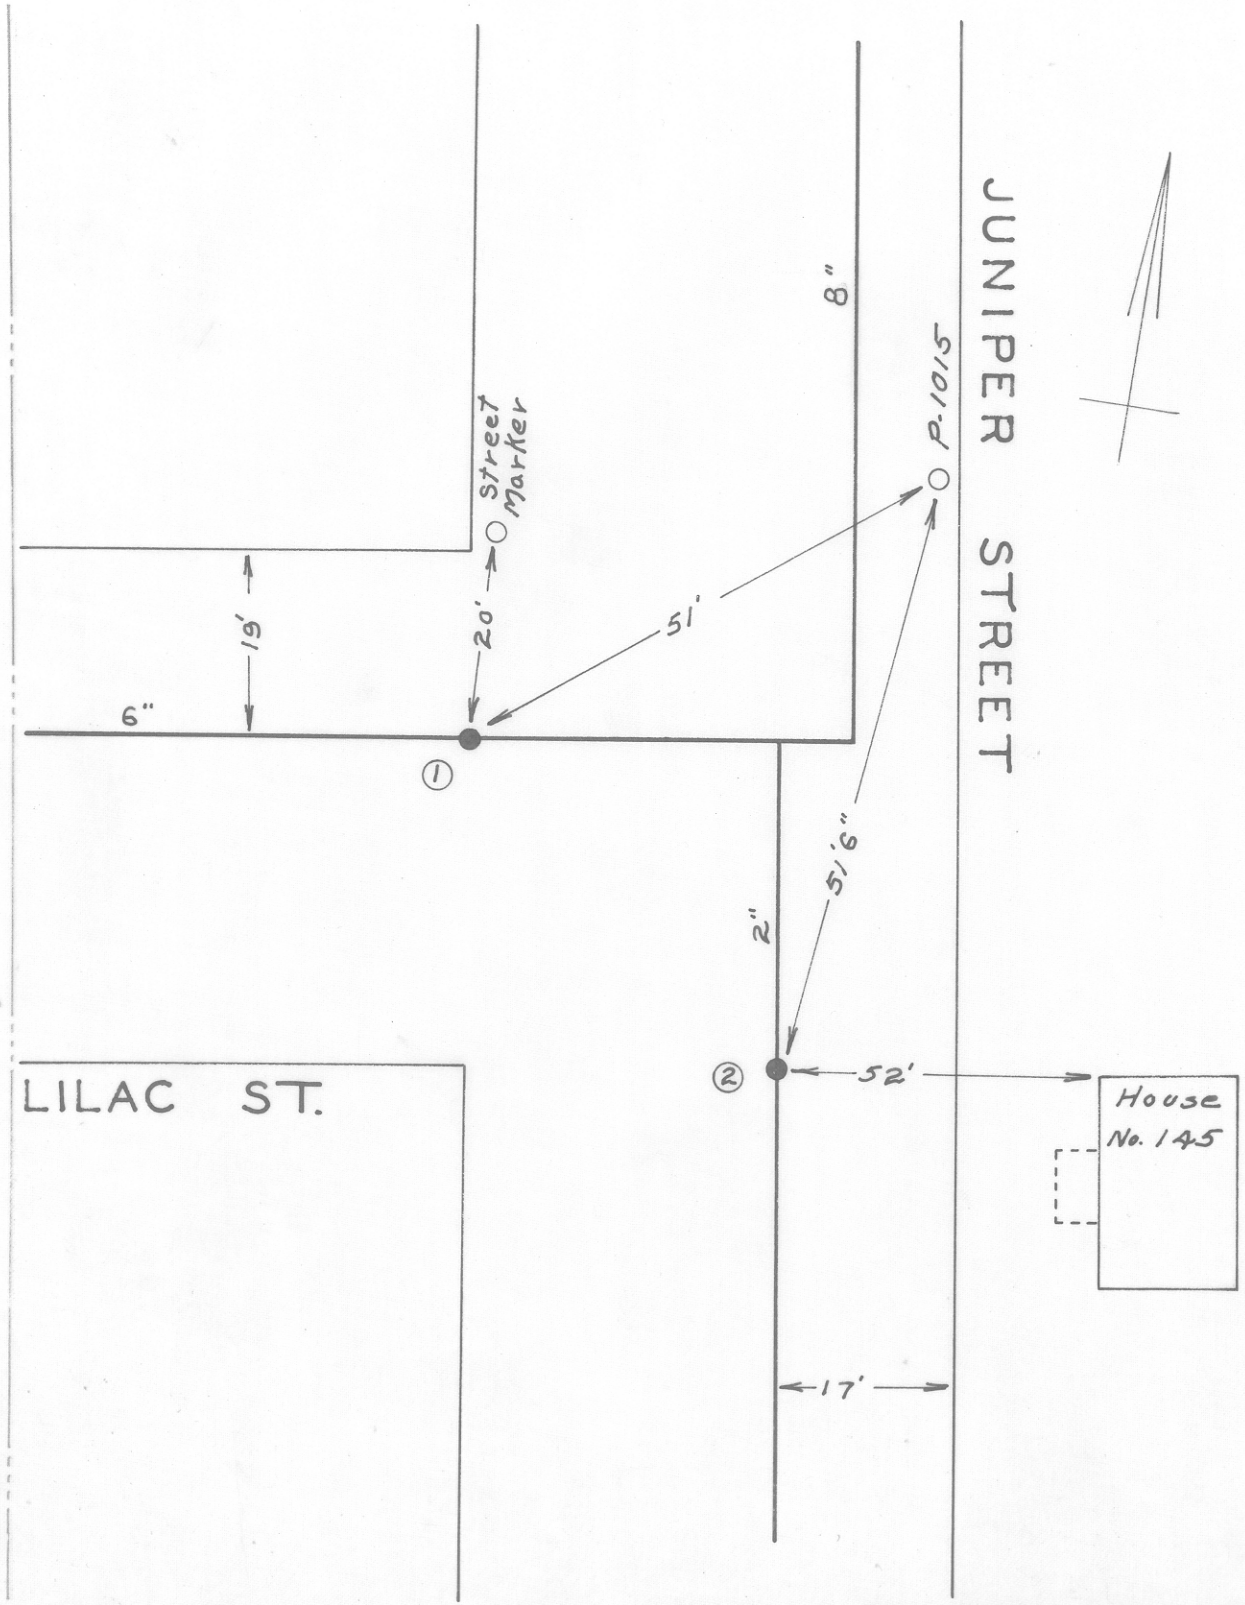

DATE	NO.	SIZE	MAKE	OPEN	TURNS
	1	6"	MUELLER	R	20
	2	2"	DARLING	R	
	1	0	WPL		
	2	0	SPL		

CITY OF ROANOKE—WATER DEPT.

VALVE DIAGRAM

JUNIPER ST. & LILAC AVE. N. W.

SEC. MAP 263

DATE PAGE NO.

"IMPERIAL" TRACING CLOTH K & E CO., N. Y.