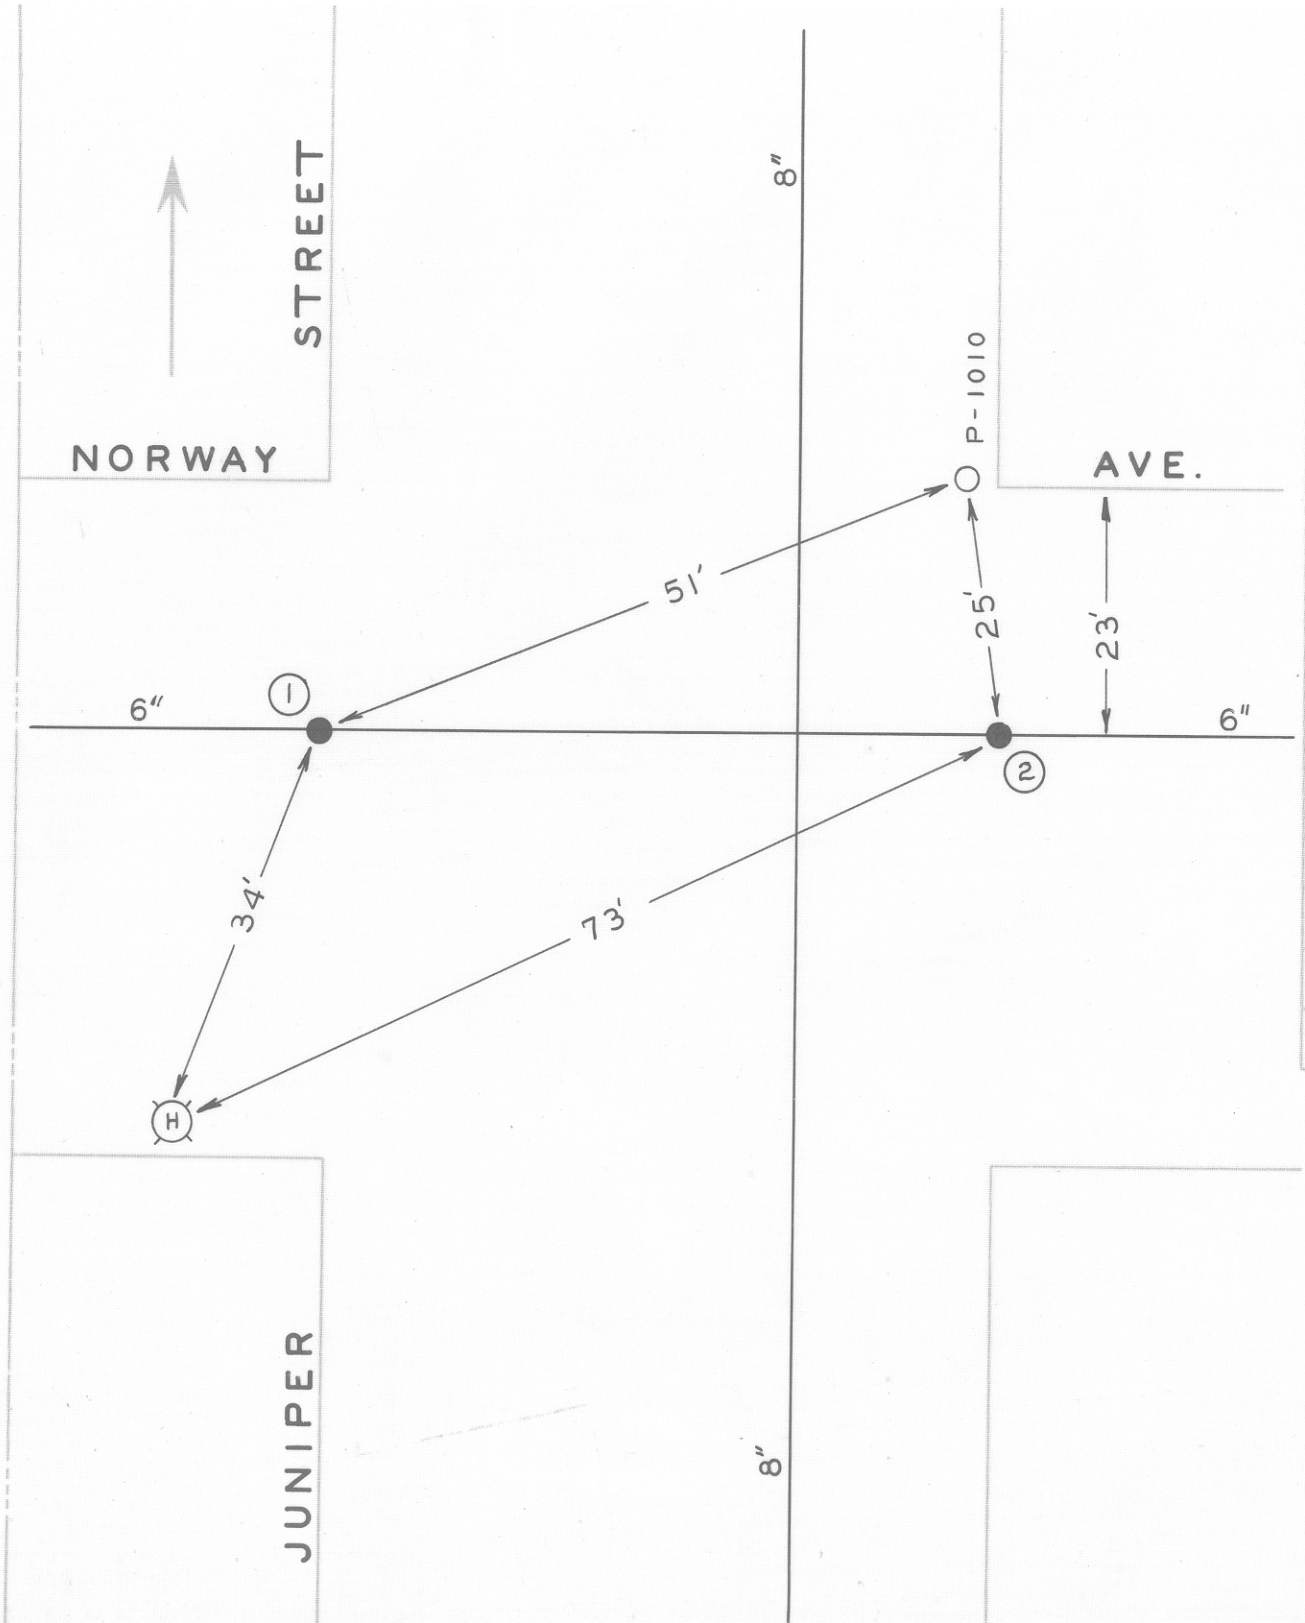

DATE	NO.	SIZE	MAKE	OPEN	TURNS
	1	6"	MUE.	R	20
	2	6"	MUE.	R	20
	1	0	WPL		
	2	0	EPL		

CITY OF ROANOKE—WATER DEP'T

VALVE DIAGRAM

JUNIPER ST. &

NORWAY AVE. N.W.

SEC. MAP 263

DATE PAGE NO.