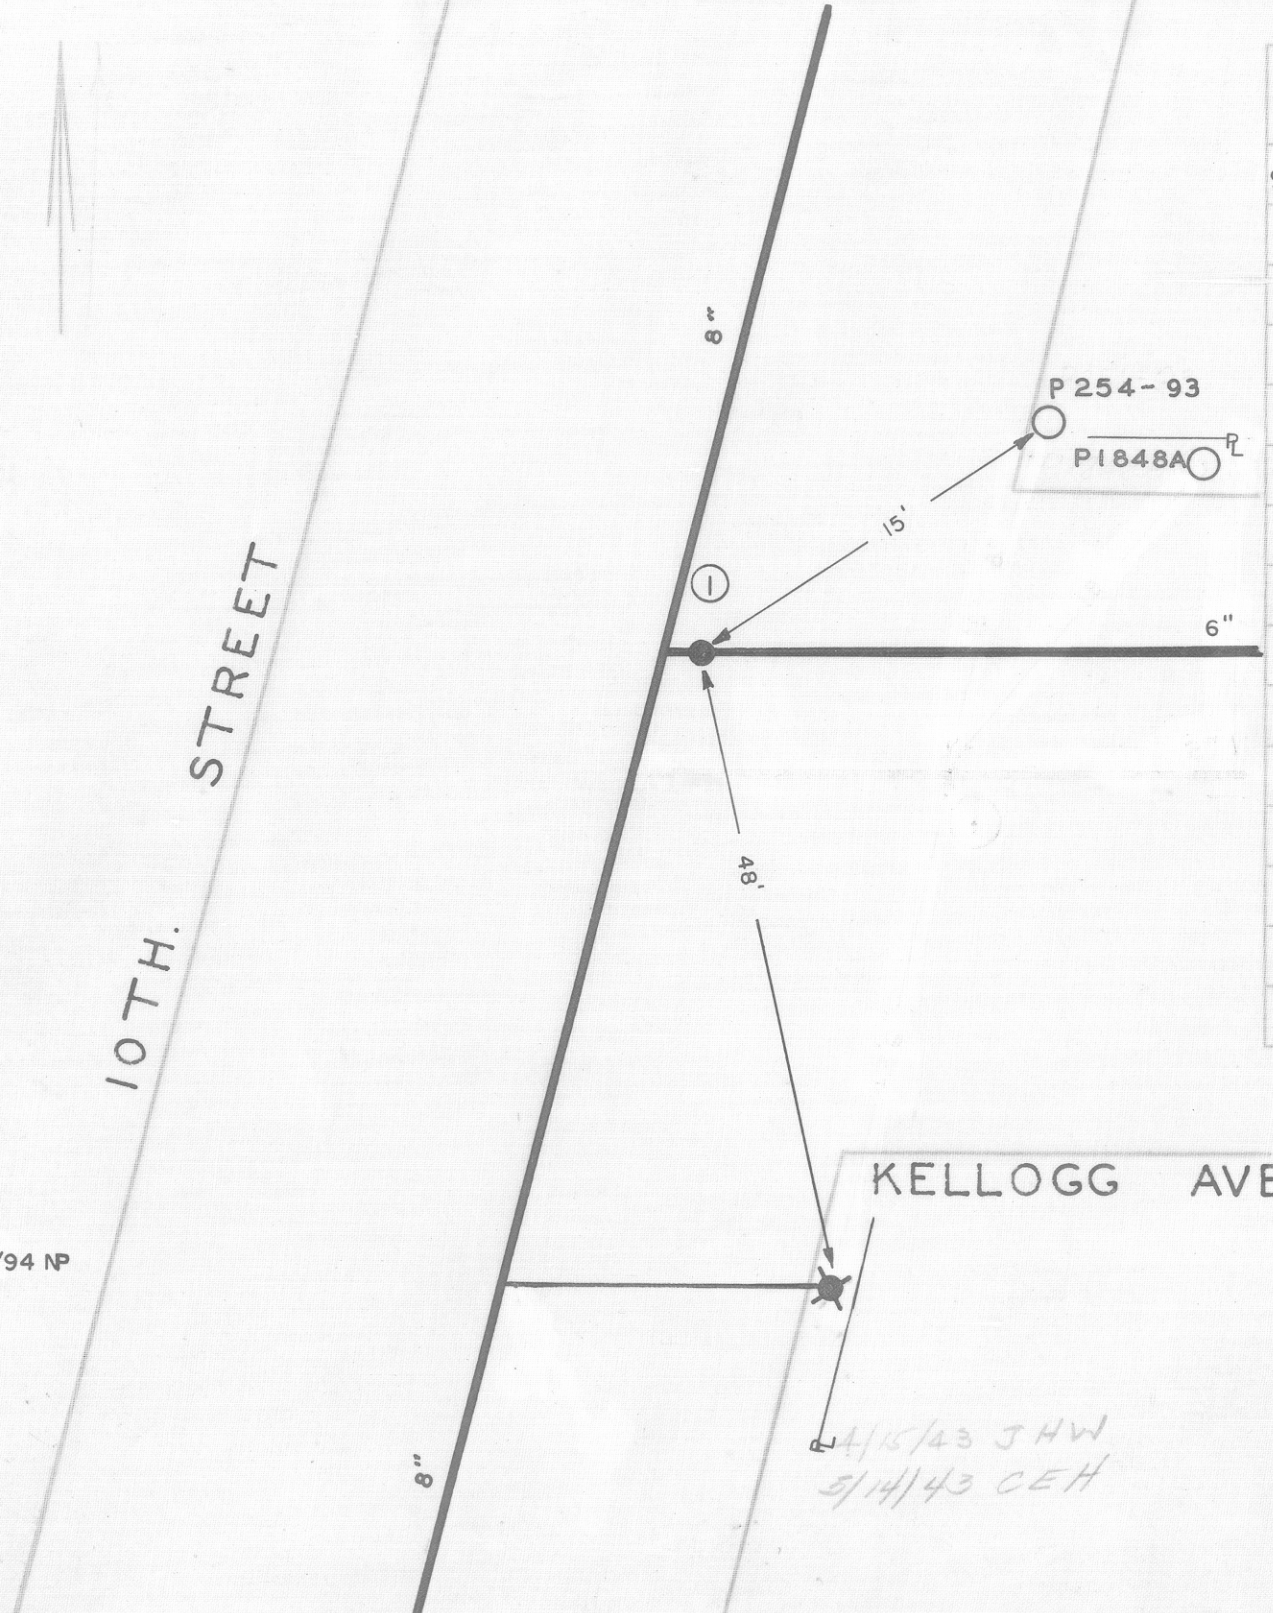

DATE	NO.	SIZE	MAKE	OPEN	TURNS
9/93	1	6"	MUELLER	R	

8/94 NP

CITY OF ROANOKE—WATER DEP'T
VALVE DIAGRAM

KELLOGG AVE. &
10TH. ST. EXTENSION
N. W.

SEC. MAP 204,205

DATE PAGE NO. N.W. 62