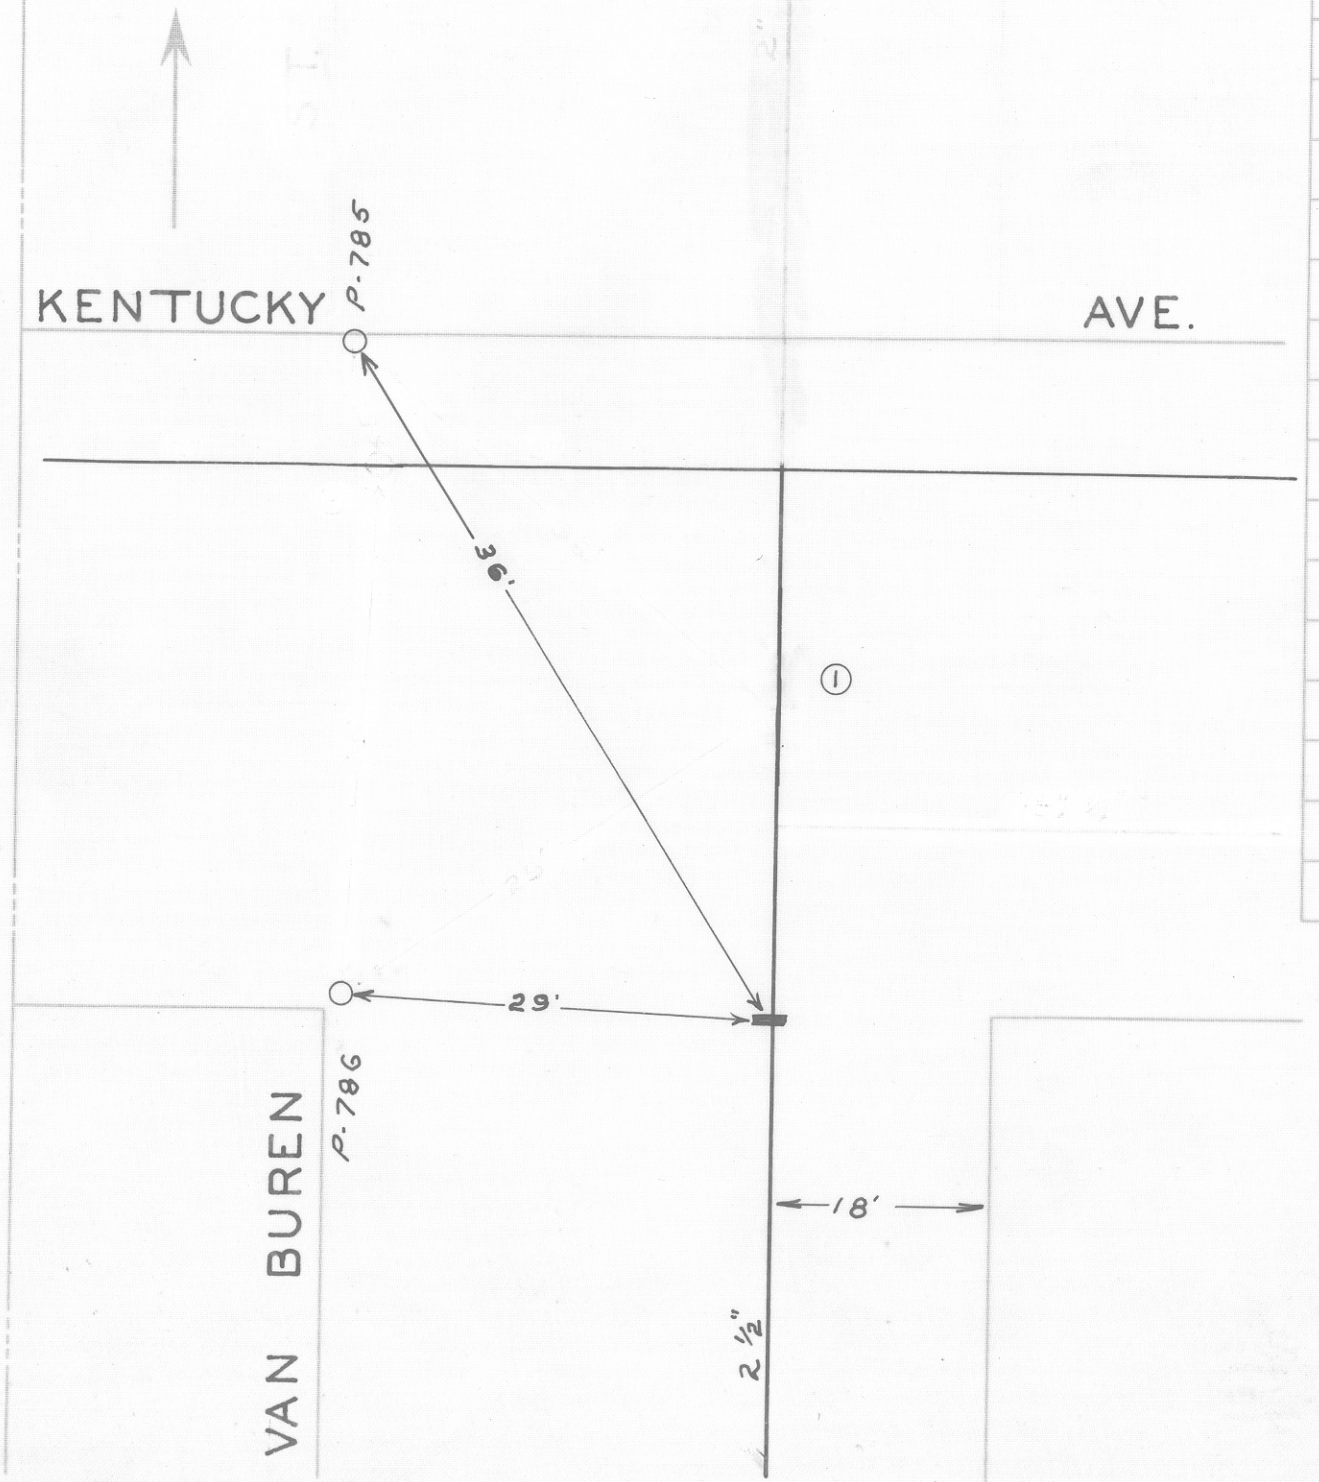

DATE	NO.	SIZE	MAKE	OPEN	TURNS
	1	2"			
	1	29'-S	NPL		

CITY OF ROANOKE—WATER DEP'T

VALVE DIAGRAM

KENTUCKY AVE. &

VAN BUREN ST. N.W.

SEC. MAP 267

DATE PAGE NO.