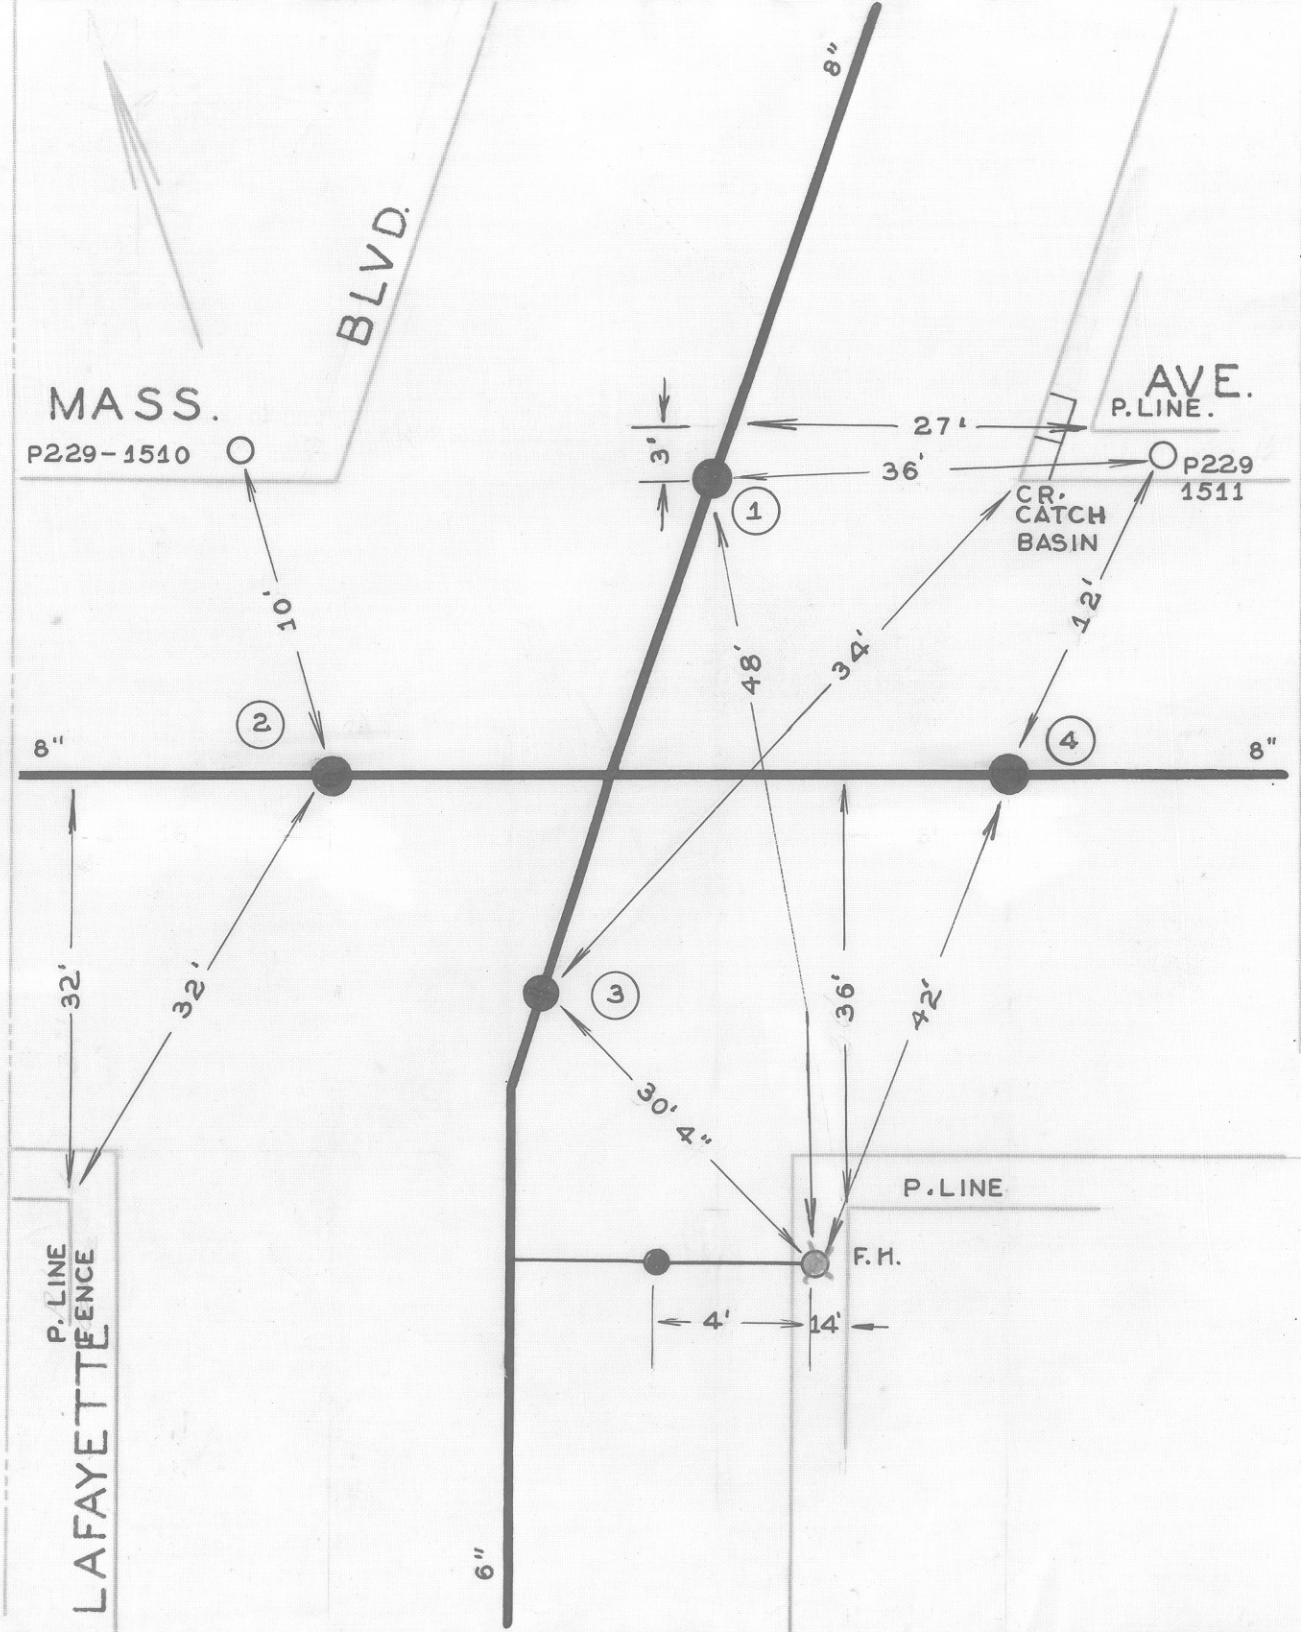

DATE	NO.	SIZE	MAKE	OPEN	TURNS
1949	1	8"	DARLING	R	27
1949	2	8"	DARLING	R	27
1919	3	6"	DARLING	R	20
1949	4	8"	DARLING	R	27
	1	12'-S	NPL		
	2	0	WPL		
	3	27'-N	SPL		
	4	0	EPL		

CITY OF ROANOKE—WATER DEP'T

VALVE DIAGRAM

LAFAYETTE BLVD. &
MASSACHUSETTS AVE.
N.W.

SEC. MAP 245, 243

DATE PAGE NO. N.W. 262