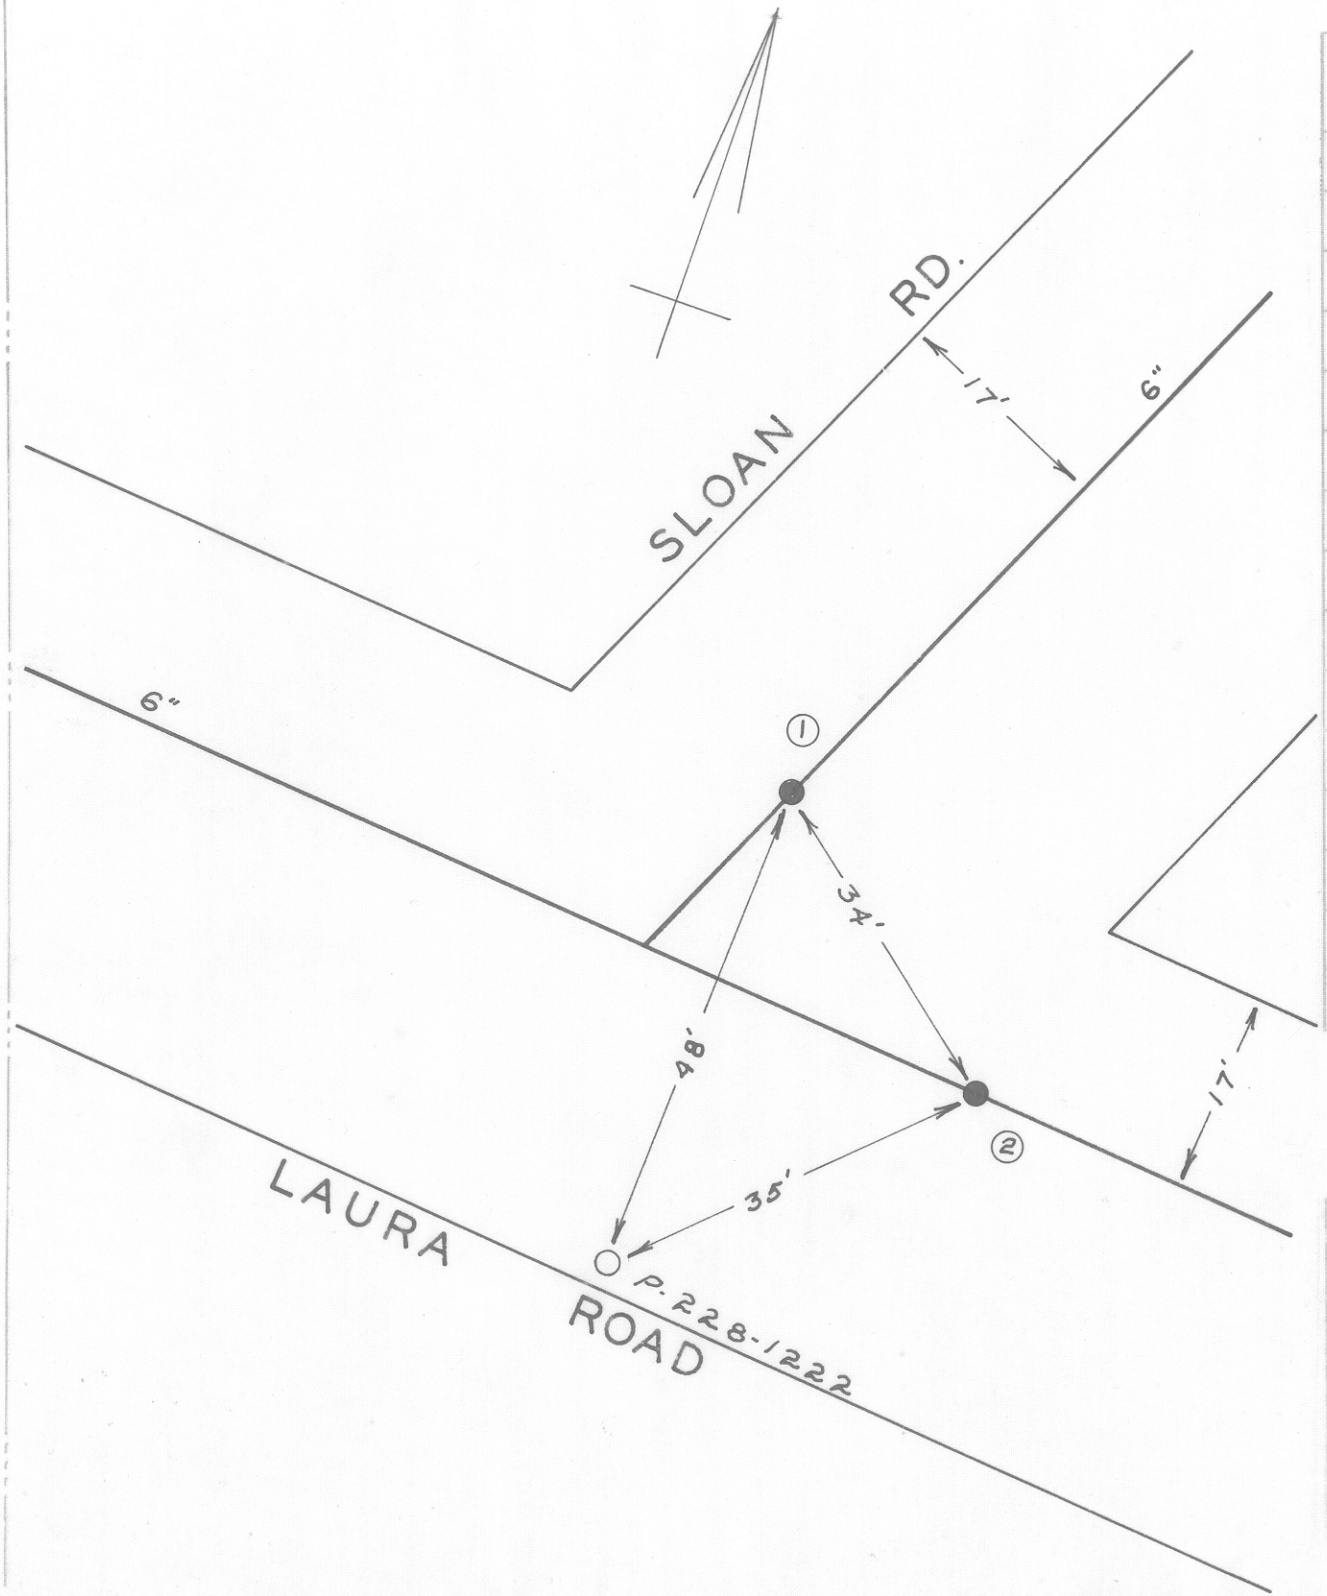

DATE	NO.	SIZE	MAKE	OPEN	TURNS
1956	1	6"	MUELLER	R	21
1956	2	6"	MUELLER	R	21
	1	0	NPL		
	2	0	EPL		

CITY OF ROANOKE — WATER DEPT.

VALVE DIAGRAM

LAURA RD. & SLOAN RD.

N. W.

SEC. MAP 614 N.W.

DATE PAGE NO.

"IMPERIAL" TRACING CLOTH
K & E CO., N. Y.