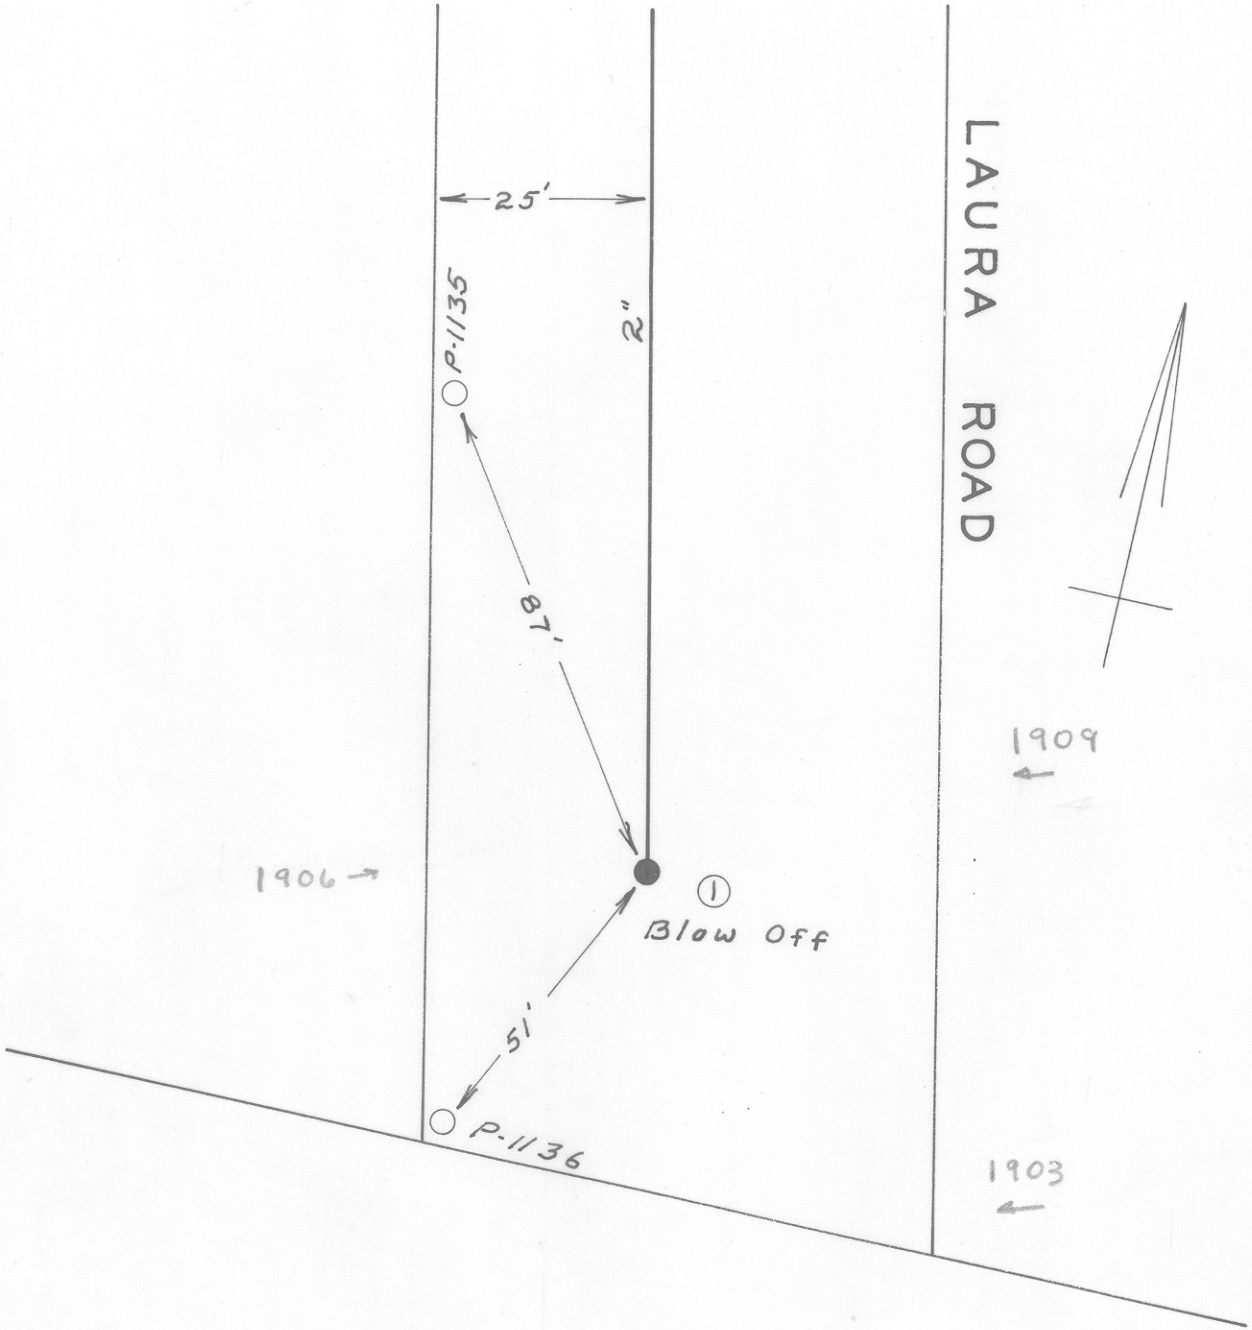

DATE	NO.	SIZE	MAKE	OPEN	TURNS
1954	1	2"	DARLING	R	7
	1	475'-S	SPL		

CITY OF ROANOKE—WATER DEPT.

VALVE DIAGRAM

LAURA RD. 475'-S. OF

NORTHWOOD DR. N. W.

SEC. MAP 614

DATE PAGE NO.

"IMPERIAL" TRACING CLOTH
K & E CO., N. Y.