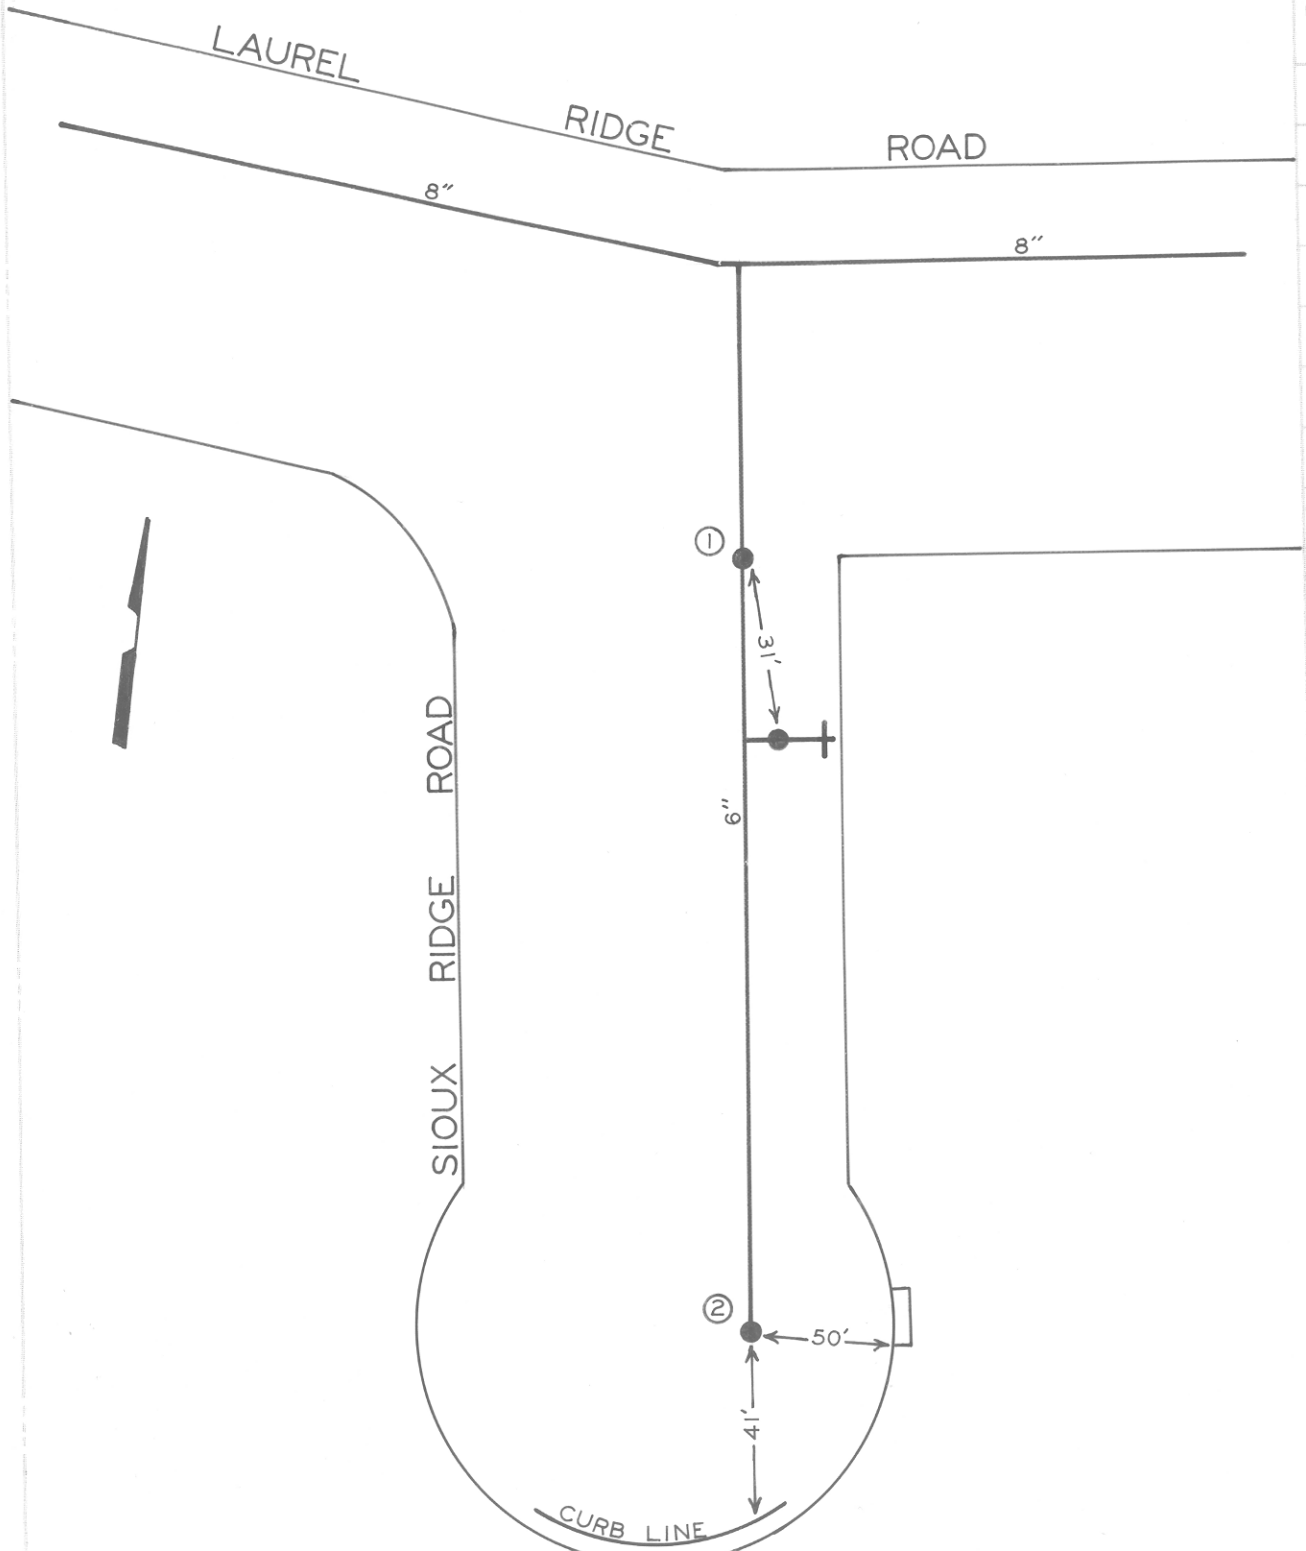

DATE	NO.	SIZE	MAKE	OPEN	TURNS
69	1	6"	MUELLER	R	21
69	2	2"	BLOW OFF	L	

CITY OF ROANOKE—WATER DEP'T

VALVE DIAGRAM

LAUREL RIDGE ROAD &
SIOUX RIDGE ROAD N.W.

SEC. MAP 649

DATE PAGE NO.