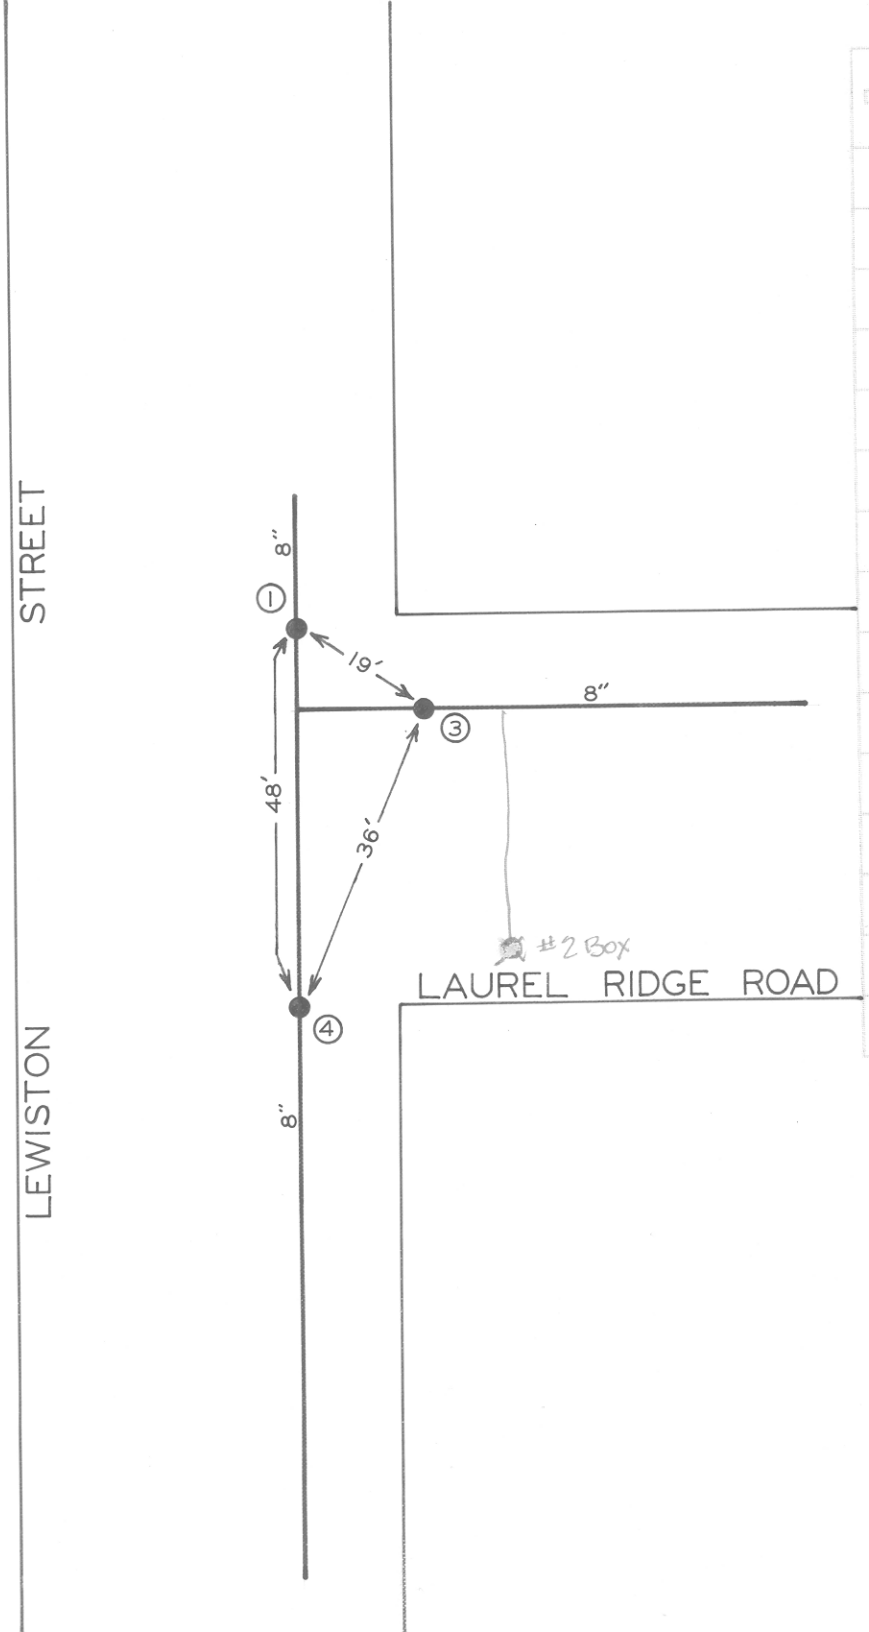

DATE	NO.	SIZE	MAKE	OPEN	TURNS
69	1	8"	MUELLER	R	27
69	2	8"	MUELLER	R	27
69	3	8"	MUELLER	R	27
	1	2'S	OF N.P.L.		
	2	0	S.P.L.		
	3	4'E	OF E.P.L.		

CITY OF ROANOKE—WATER DEP'T

VALVE DIAGRAM

LAUREL RIDGE ROAD &
LEWISTON STREET N.W.

SEC. MAP 642, 649

DATE PAGE NO.