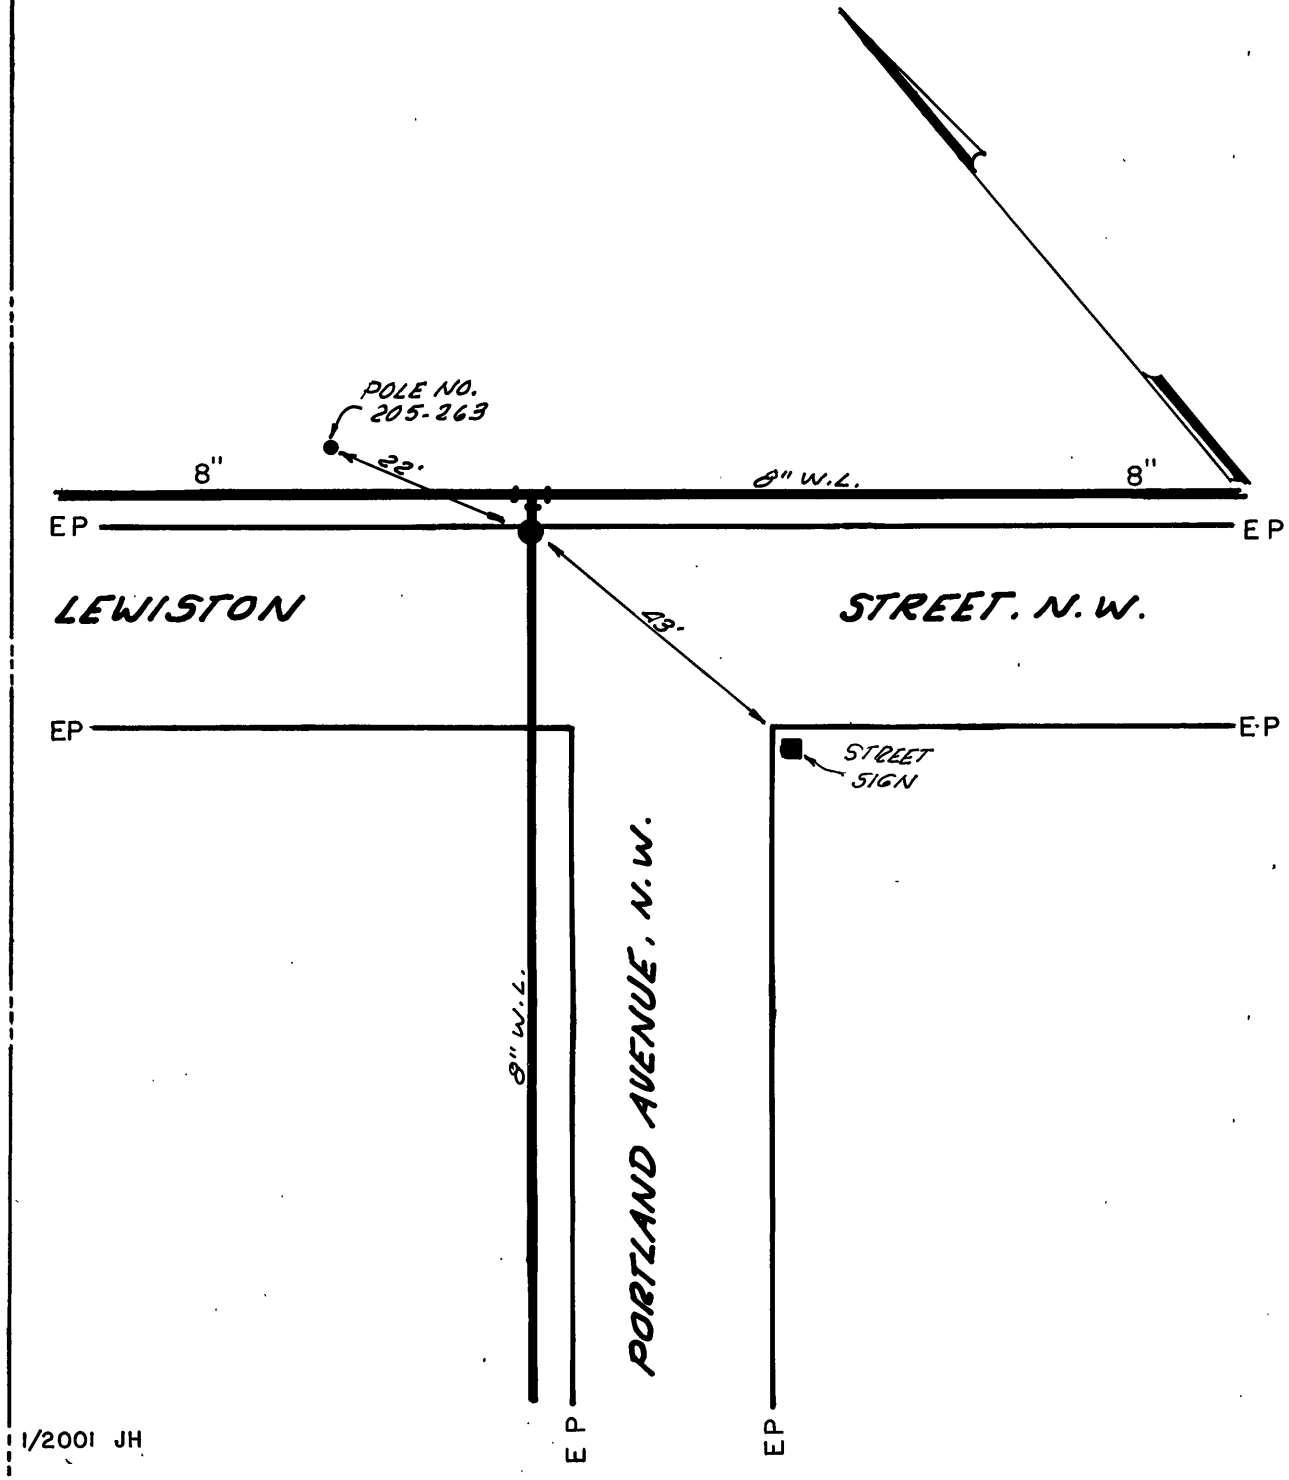

DATE	NO.	SIZE	MAKE	OPEN	TURNS
12/84	1.	8"	TAPPING VALVE	R	

1/2001 JH

CITY OF ROANOKE—WATER DEP'T

VALVE DIAGRAM

LEWISTON STREET &

PORTLAND AVENUE, N.W.

SEC. MAP 642

DATE 4-9-85 PAGE NO.