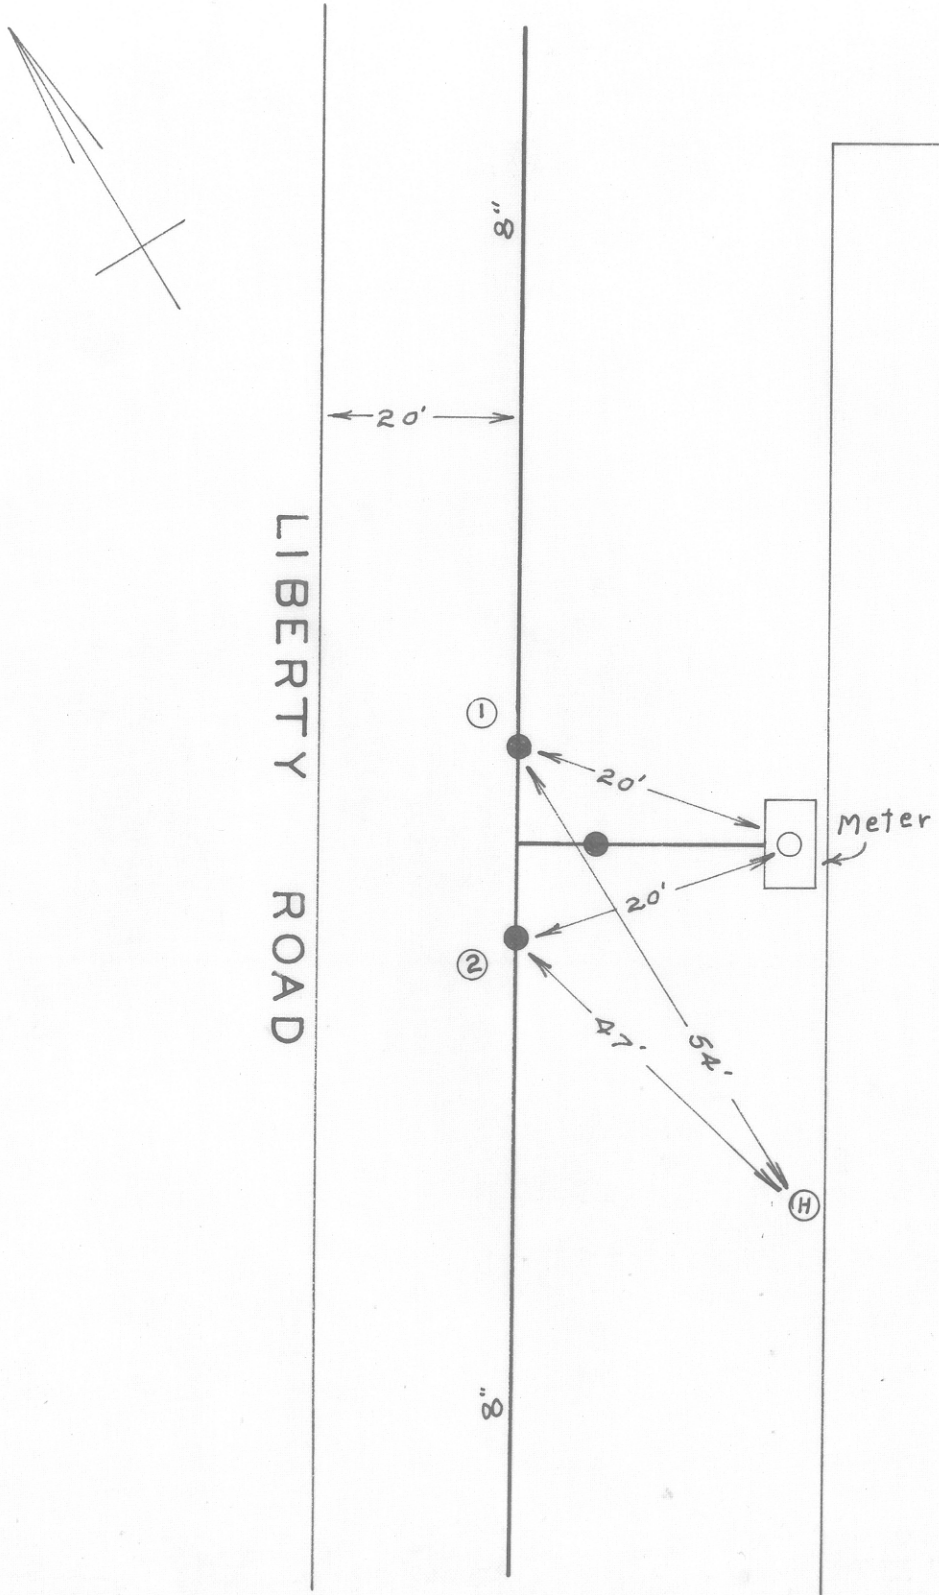

DATE	NO.	SIZE	MAKE	OPEN	TURNS
	1	8"			
	2	8"			
	1	208'-S	SPL	GANDY	
	2	216'-S	SPL		

CITY OF ROANOKE — WATER DEPT.

VALVE DIAGRAM

LIBERTY RD. 208'-S. OF GANDY DR. N.W.

SEC. MAP 204

DATE PAGE NO.

"IMPERIAL" TRACING CLOTH K & E CO., N. Y.