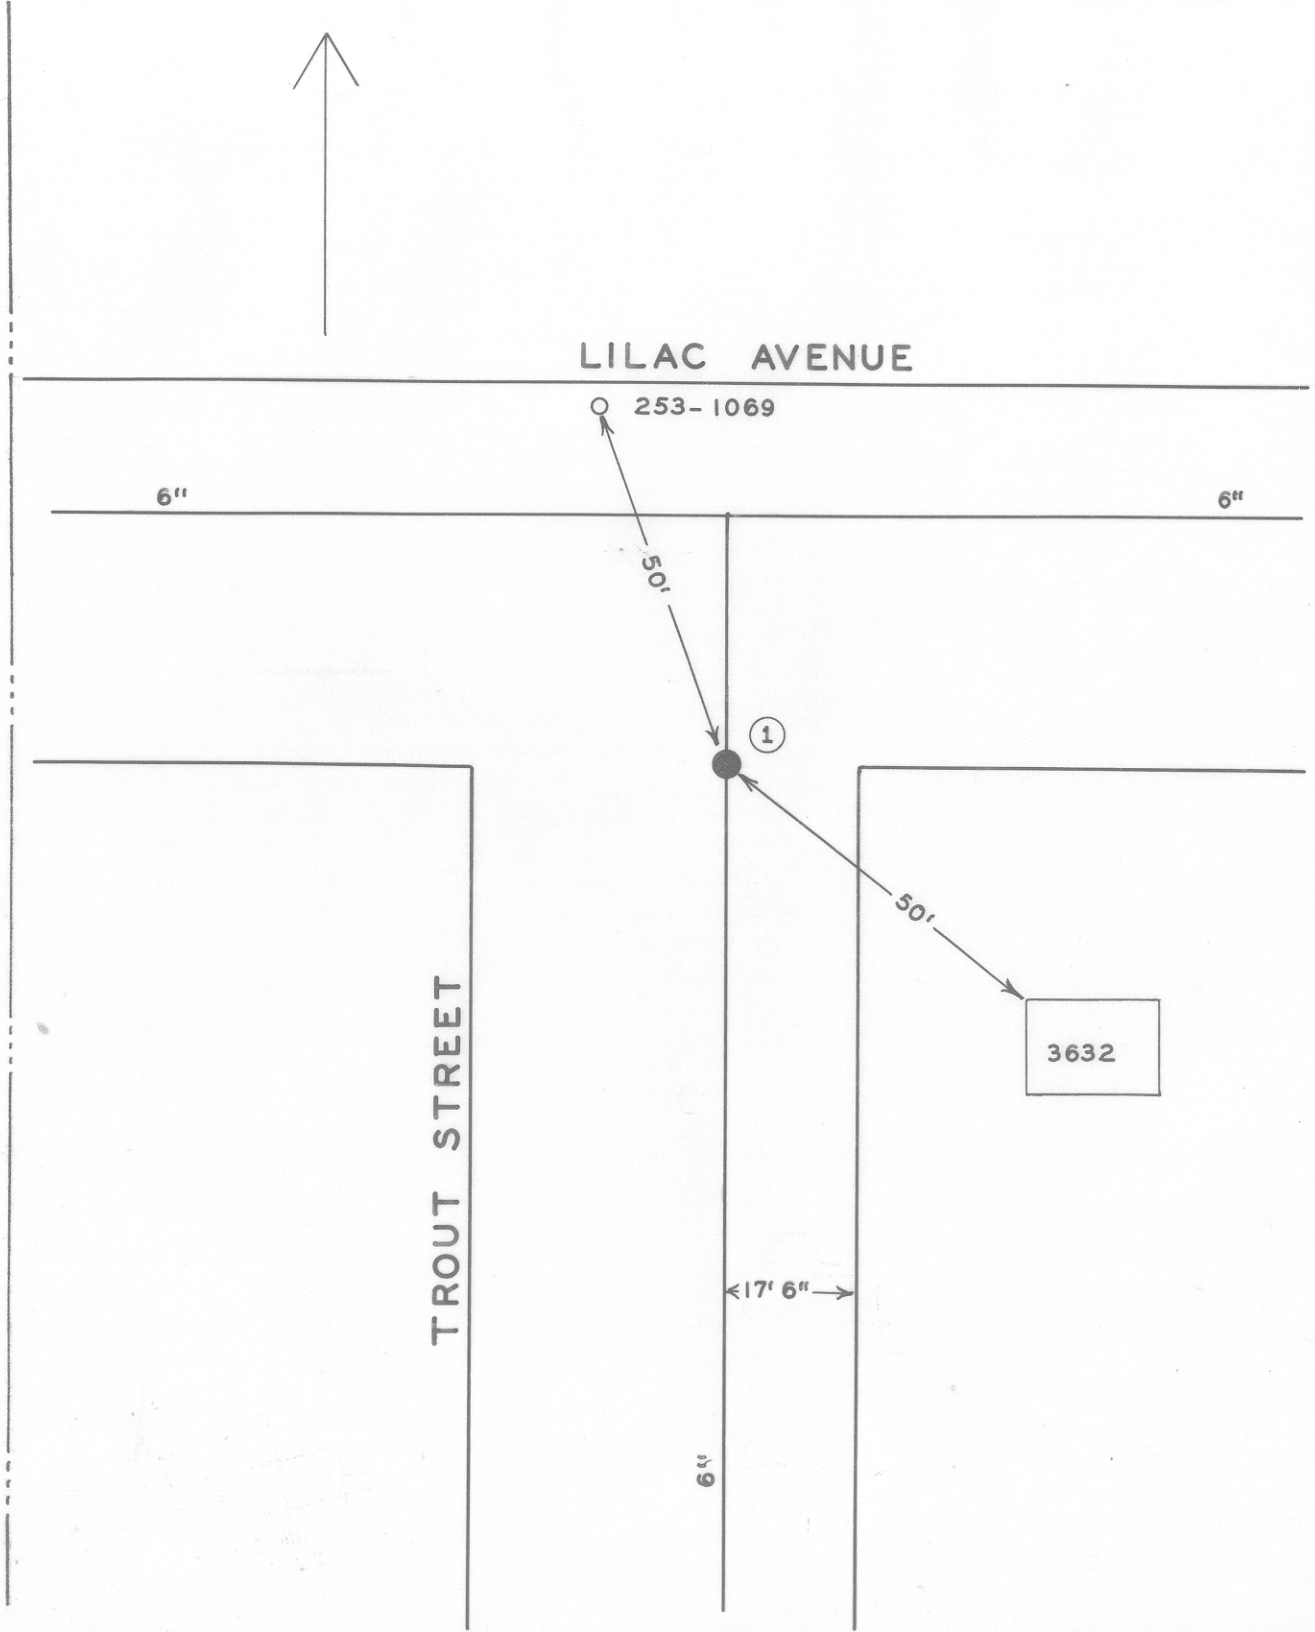

DATE	NO.	SIZE	MAKE	OPEN	TURNS
6-63	1	6"	MUELLER	R	21
	1	0	SPL		

CITY OF ROANOKE—WATER DEPT.

VALVE DIAGRAM

LILAC AVENUE & TROUT STREET N.W.

SEC. MAP 263 - 272

DATE PAGE NO.