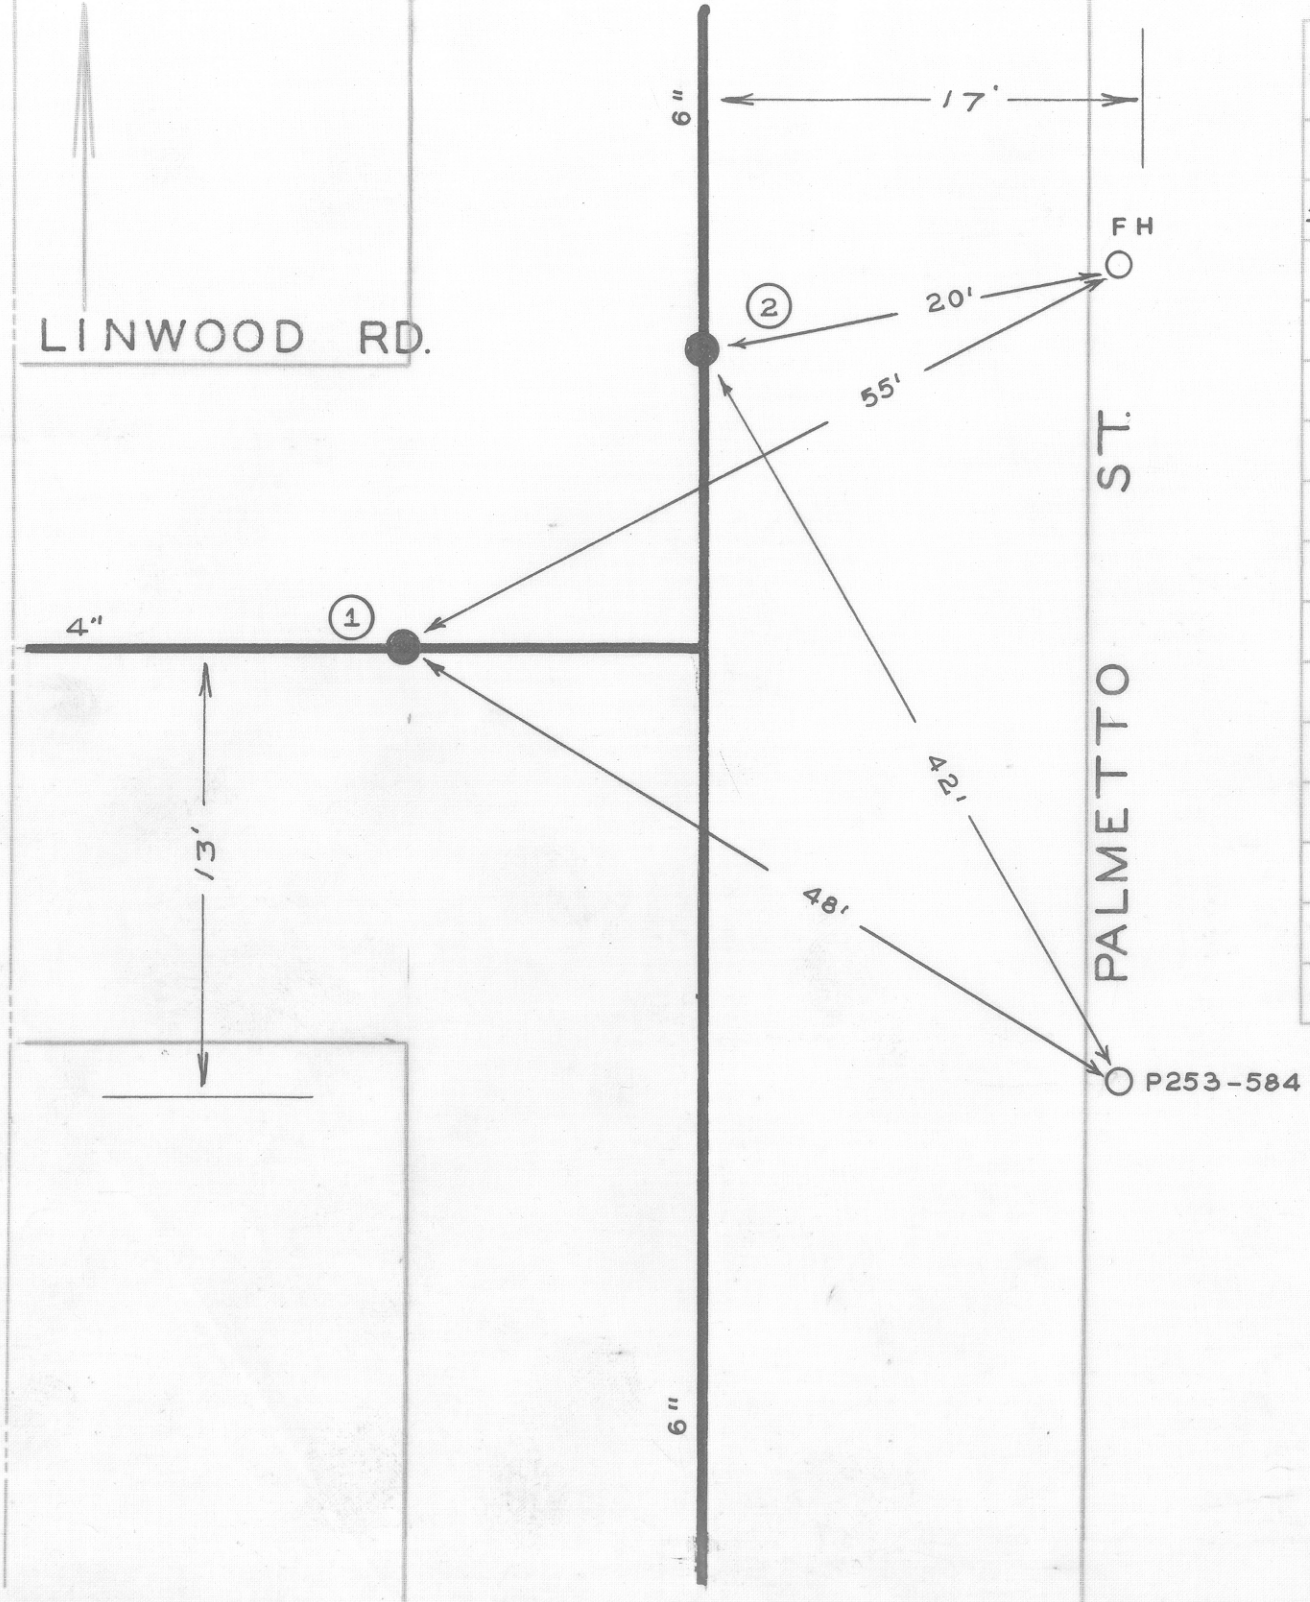

DATE	NO.	SIZE	MAKE	OPEN	TURNS
1947	1	4"	DARLING	R	9
1947	2	6"	DARLING	R	21
	1	0	WPL		
	2	8'-S	NPL		

CITY OF ROANOKE—WATER DEP'T

VALVE DIAGRAM

LINWOOD ROAD &

PALMETTO ST. N.W.

SEC. MAP 254

DATE 6/15/47 PAGE NO. NW292