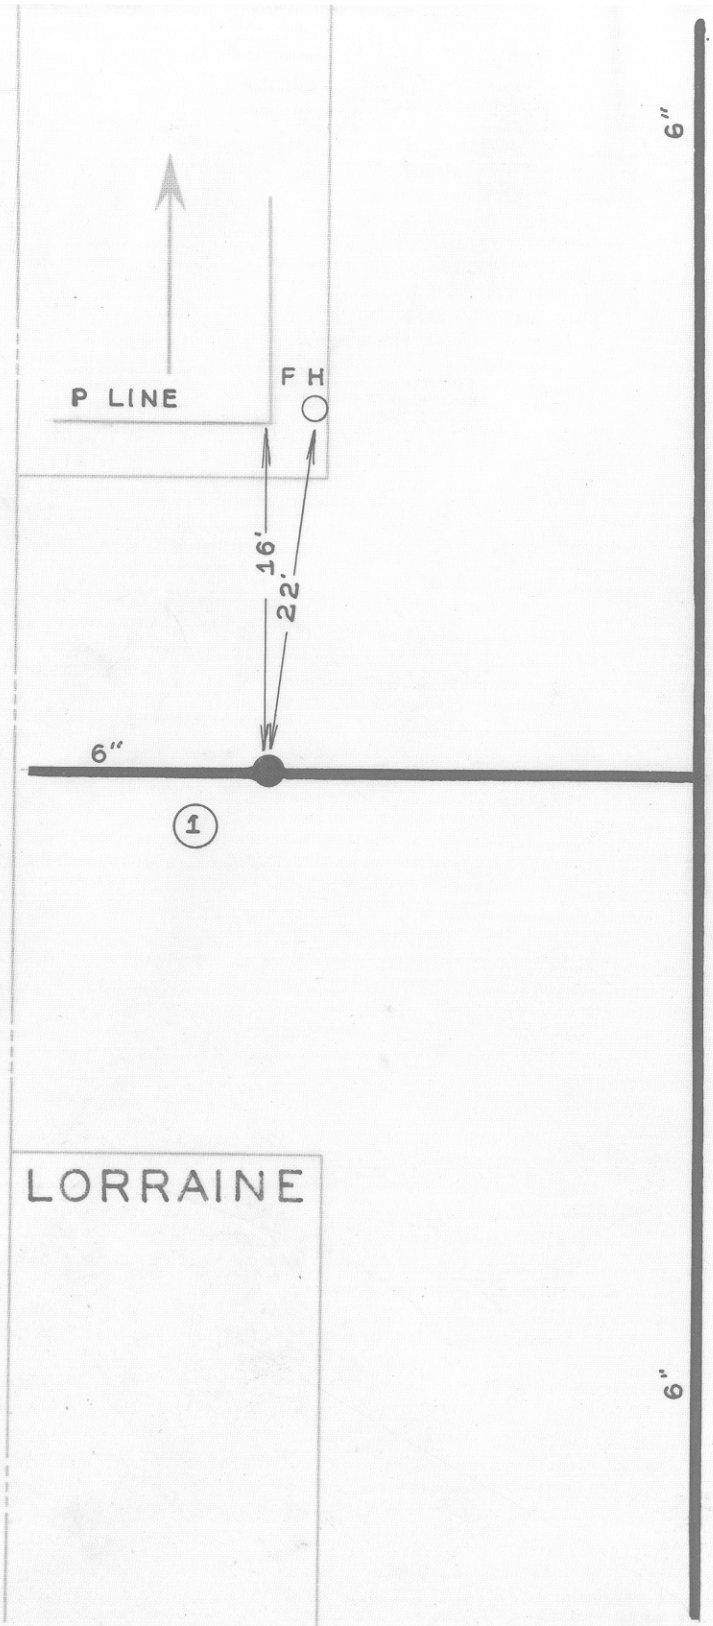

PALMETTO

RD.

STREET

DATE	NO.	SIZE	MAKE	OPEN	TURNS
1951	1	6"	DARLING	R	21
	I	O	WPL		

CITY OF ROANOKE—WATER DEP'T

VALVE DIAGRAM

LORRAINE ROAD &

PALMETTO ST. N. W.

SEC. MAP 254

DATE 1/17/51 PAGE NO NW 326