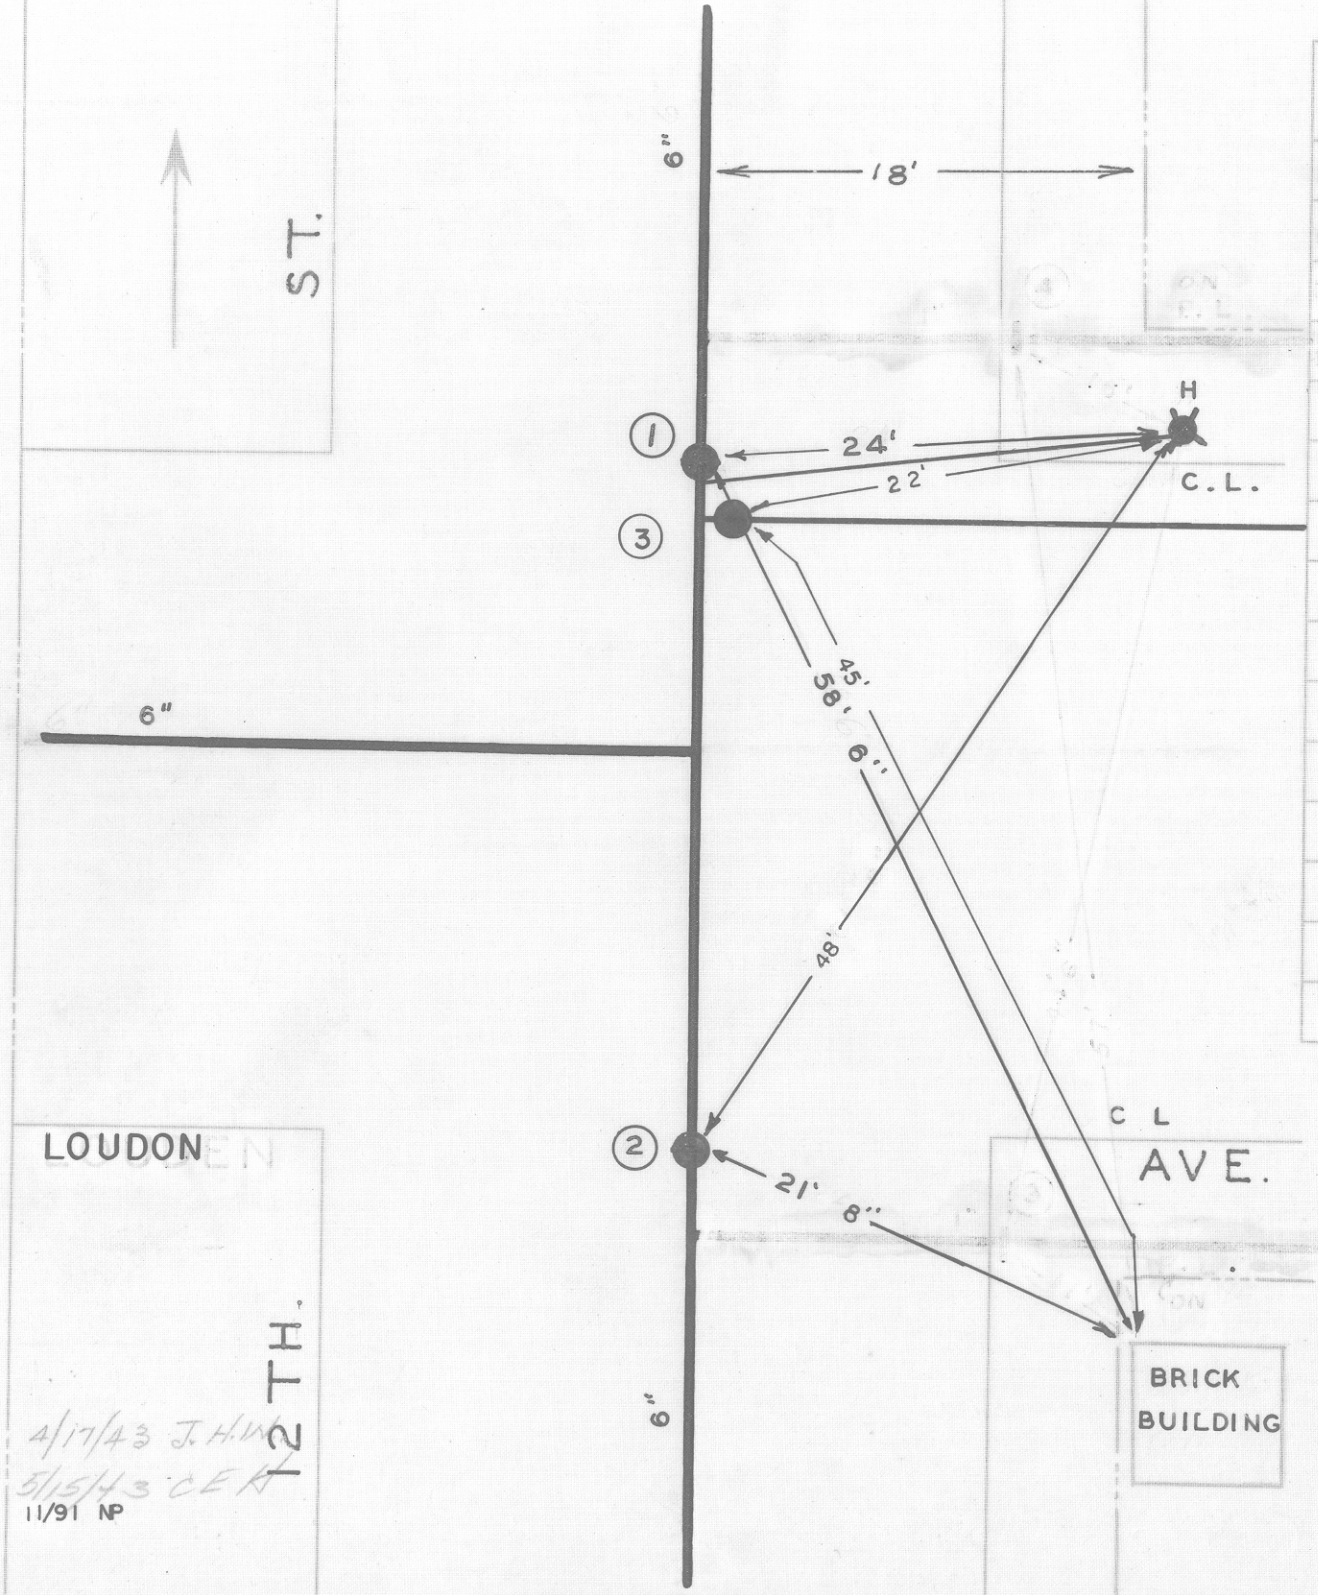

DATE	NO.	SIZE	MAKE	OPEN	TURNS
1891	1	6"		R	21
1891	2	6"		R	21
1991	3	6"	CURB COCK	R	21
1907	4	1"	CURB COCK		
	1	0	NPL		
	2	3'-N	SPL		
	3	9'-W	EPL		
	4	9'-W	EPL		

CITY OF ROANOKE—WATER DEP'T

VALVE DIAGRAM

LOUDON AVE. & 12TH. ST. N.W.

SEC. MAP 211

DATE

PAGE NO. N.W.122