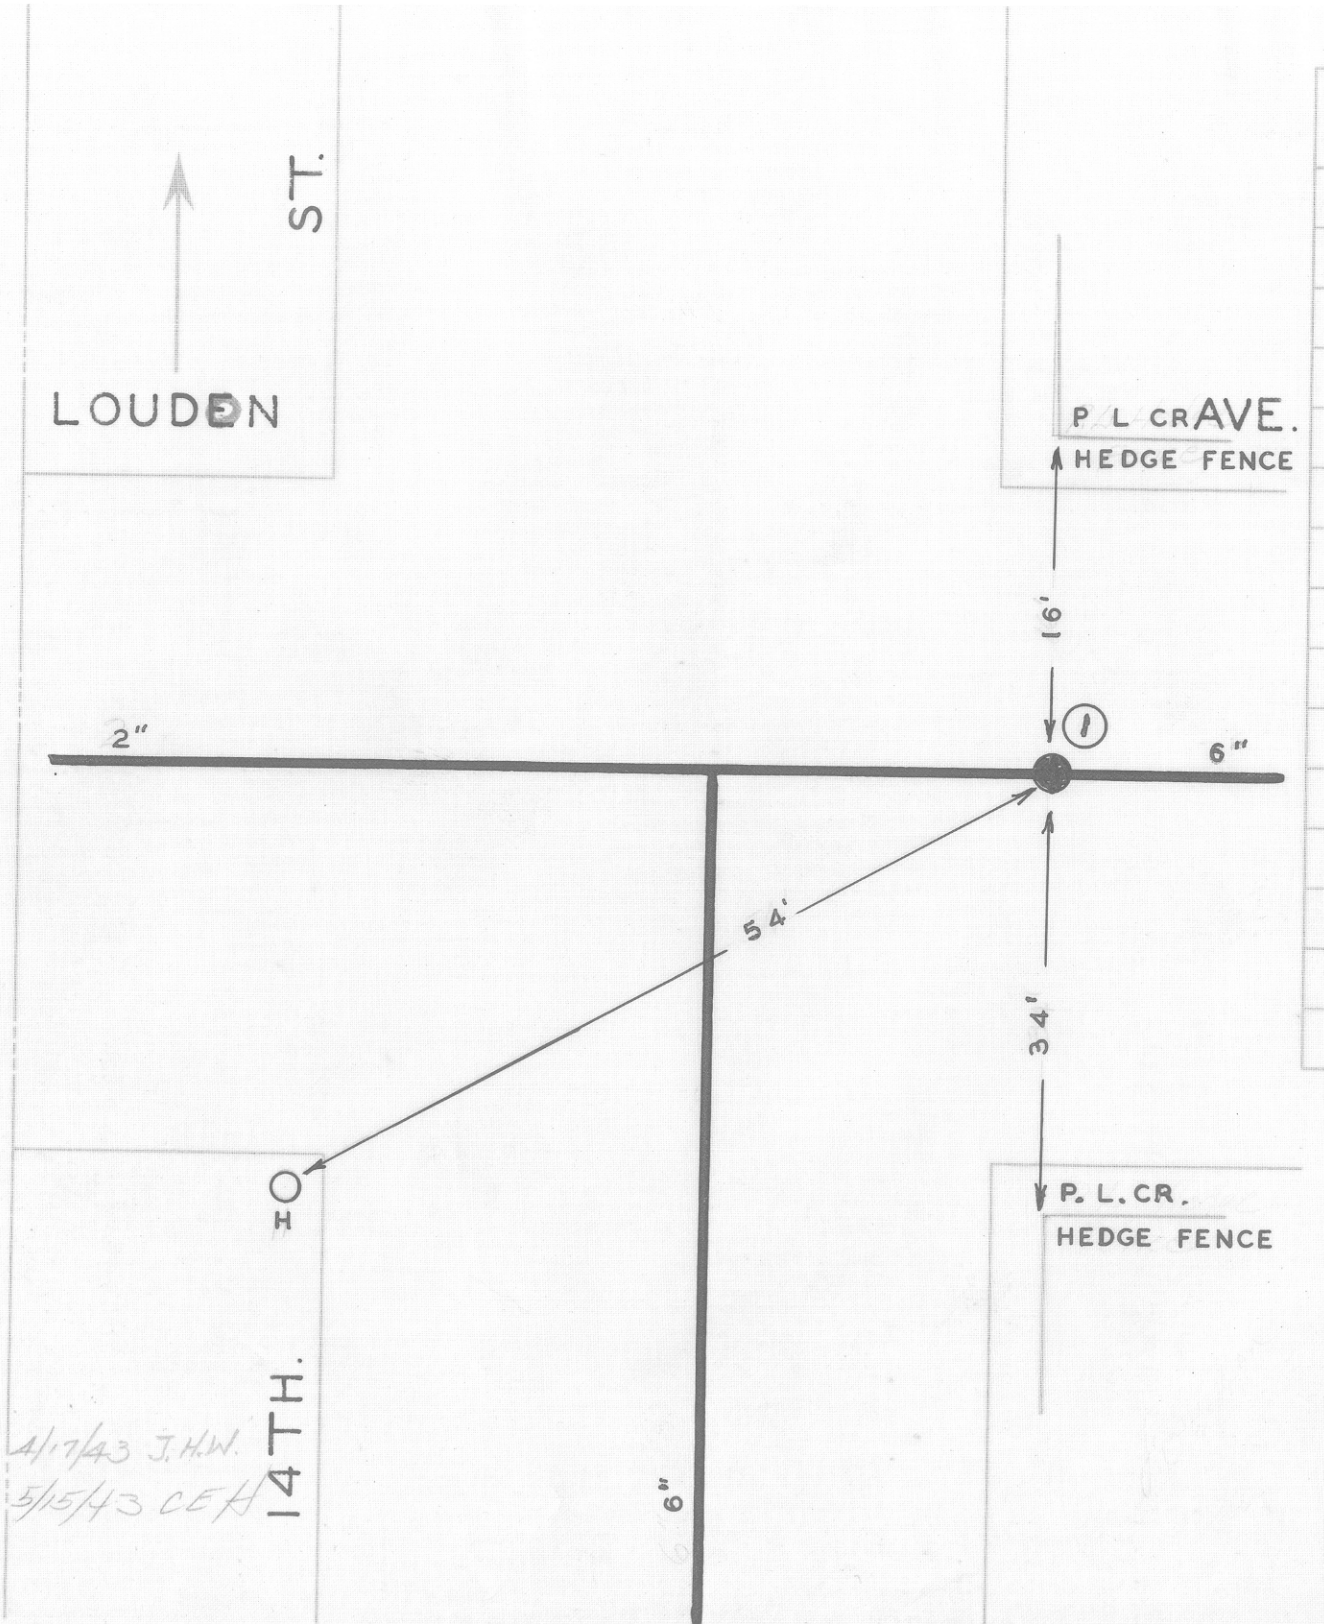

DATE	NO.	SIZE	MAKE	OPEN	TURNS
1893	1	6"		R	21 1/2
	1	0	EPL		

CITY OF ROANOKE—WATER DEP'T

VALVE DIAGRAM

LOUDON AVE. & 14TH. ST. N. W.

SEC. MAP 221

DATE

PAGE NO N.W. 123