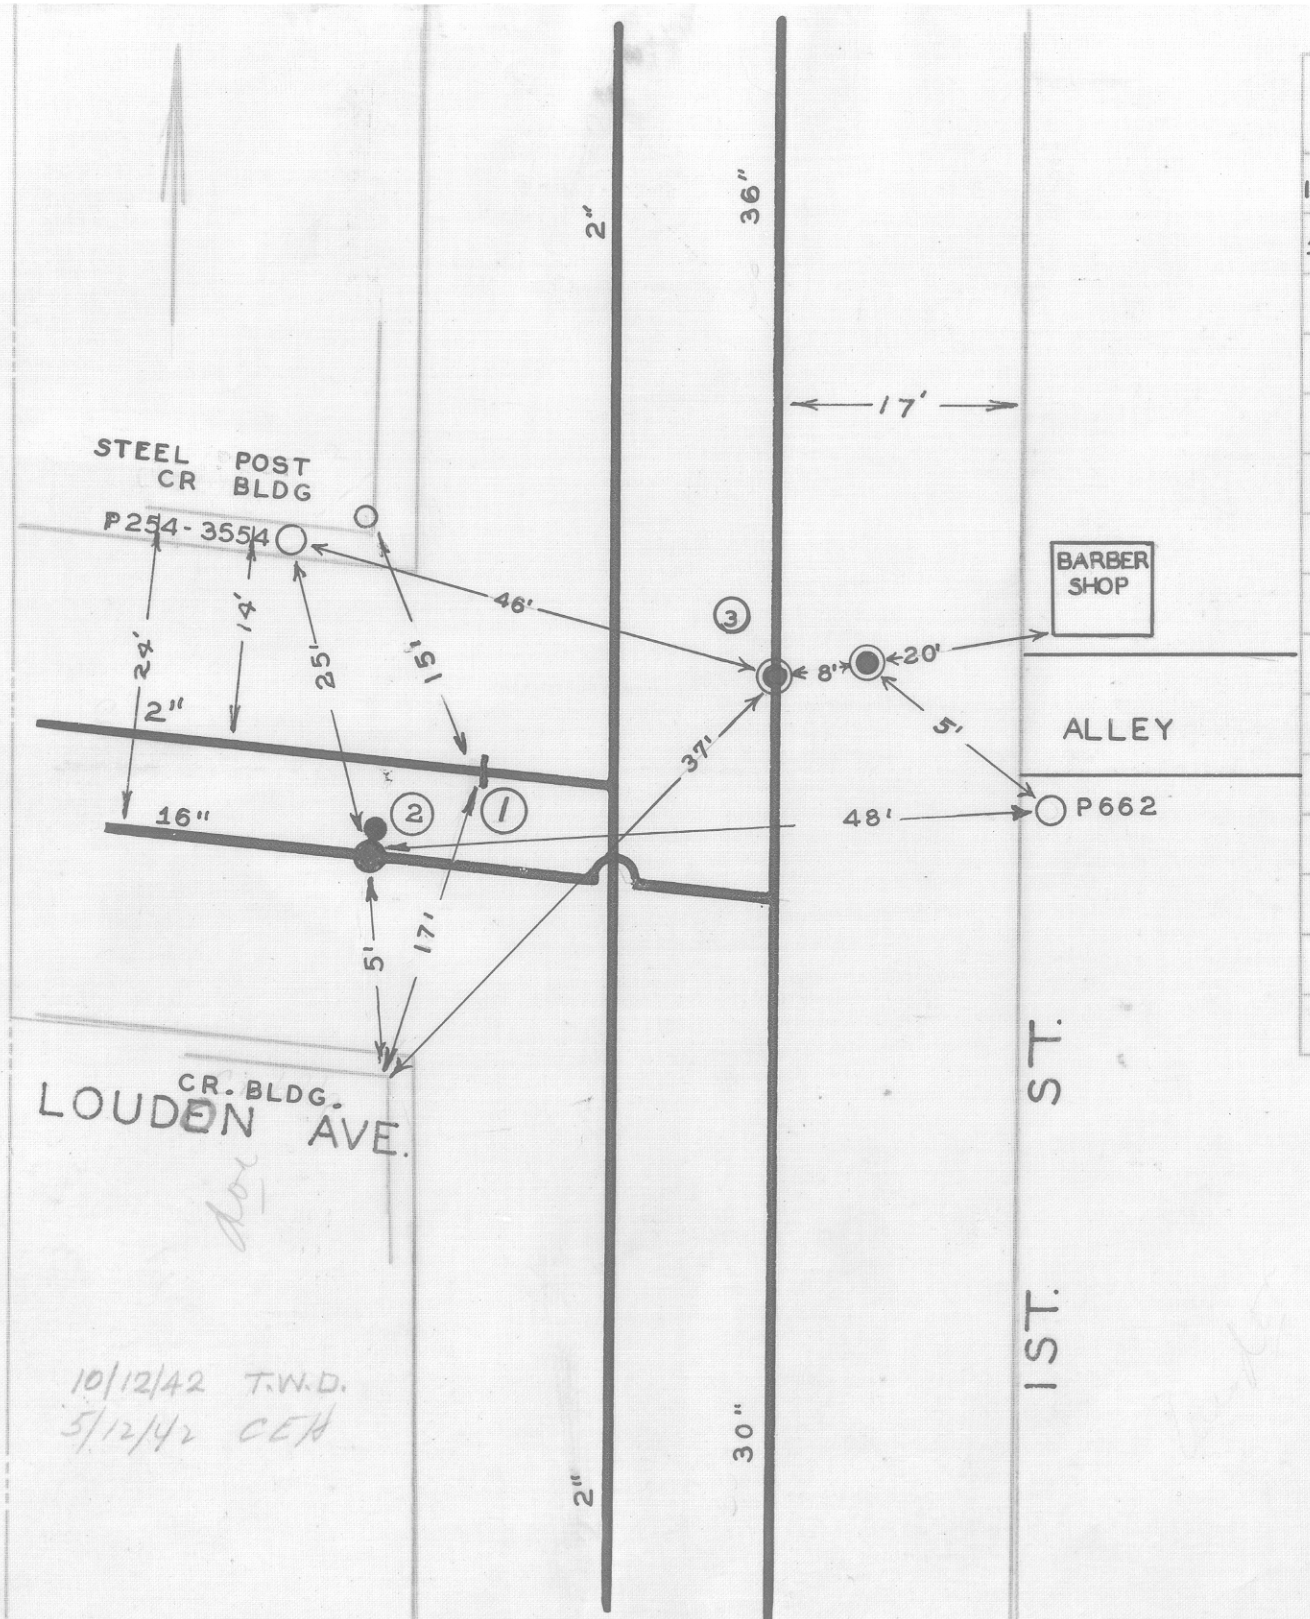

DATE	NO.	SIZE	MAKE	OPEN	TURNS
1946	1	2"		R	7 1/2
1946	2	16	M & H	L	100
		3"	BY PASS	L	9
1946	3	30"	M & H	L	125
		4"	M & H	L	9
	1	0	WPL		
	2	0	WPL		
	3	12'-S	NPL		

10/12/42 T.W.D.
5/12/42 CEH

CITY OF ROANOKE—WATER DEP'T
VALVE DIAGRAM
LOUDEN AVE. & 1 ST. ST. N.W.

SEC. MAP 201
DATE PAGE NO. N.W. 10