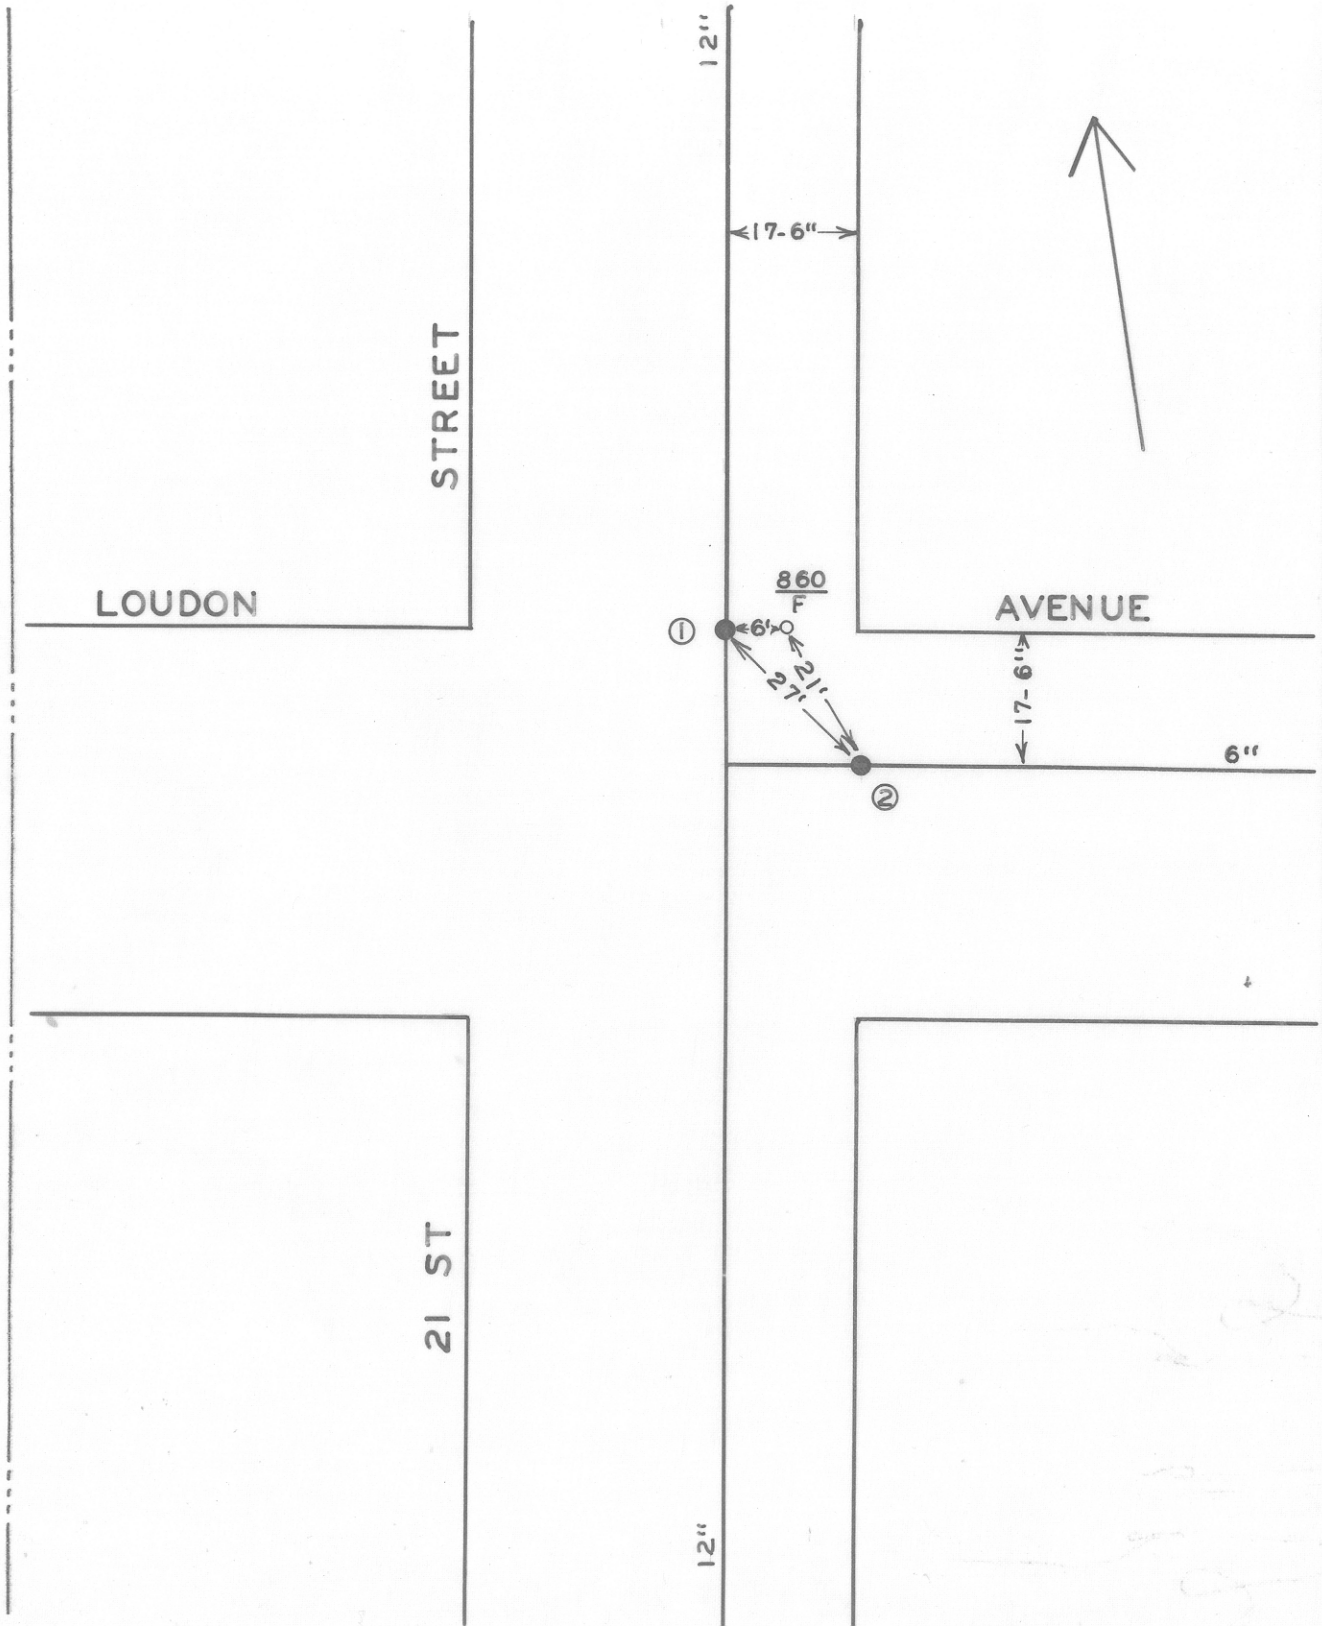

DATE	NO.	SIZE	MAKE	OPEN	TURNS
1-65	1	12"	MUELLER	R	
1-65	2	6"	MUELLER	R	
	1	0	N.P.L		
	2	0	E.P.L.		

CITY OF ROANOKE—WATER DEPT.

VALVE DIAGRAM

LOUDON AVENUE &

21ST STREET N.W.

SEC. MAP 232

DATE PAGE NO.