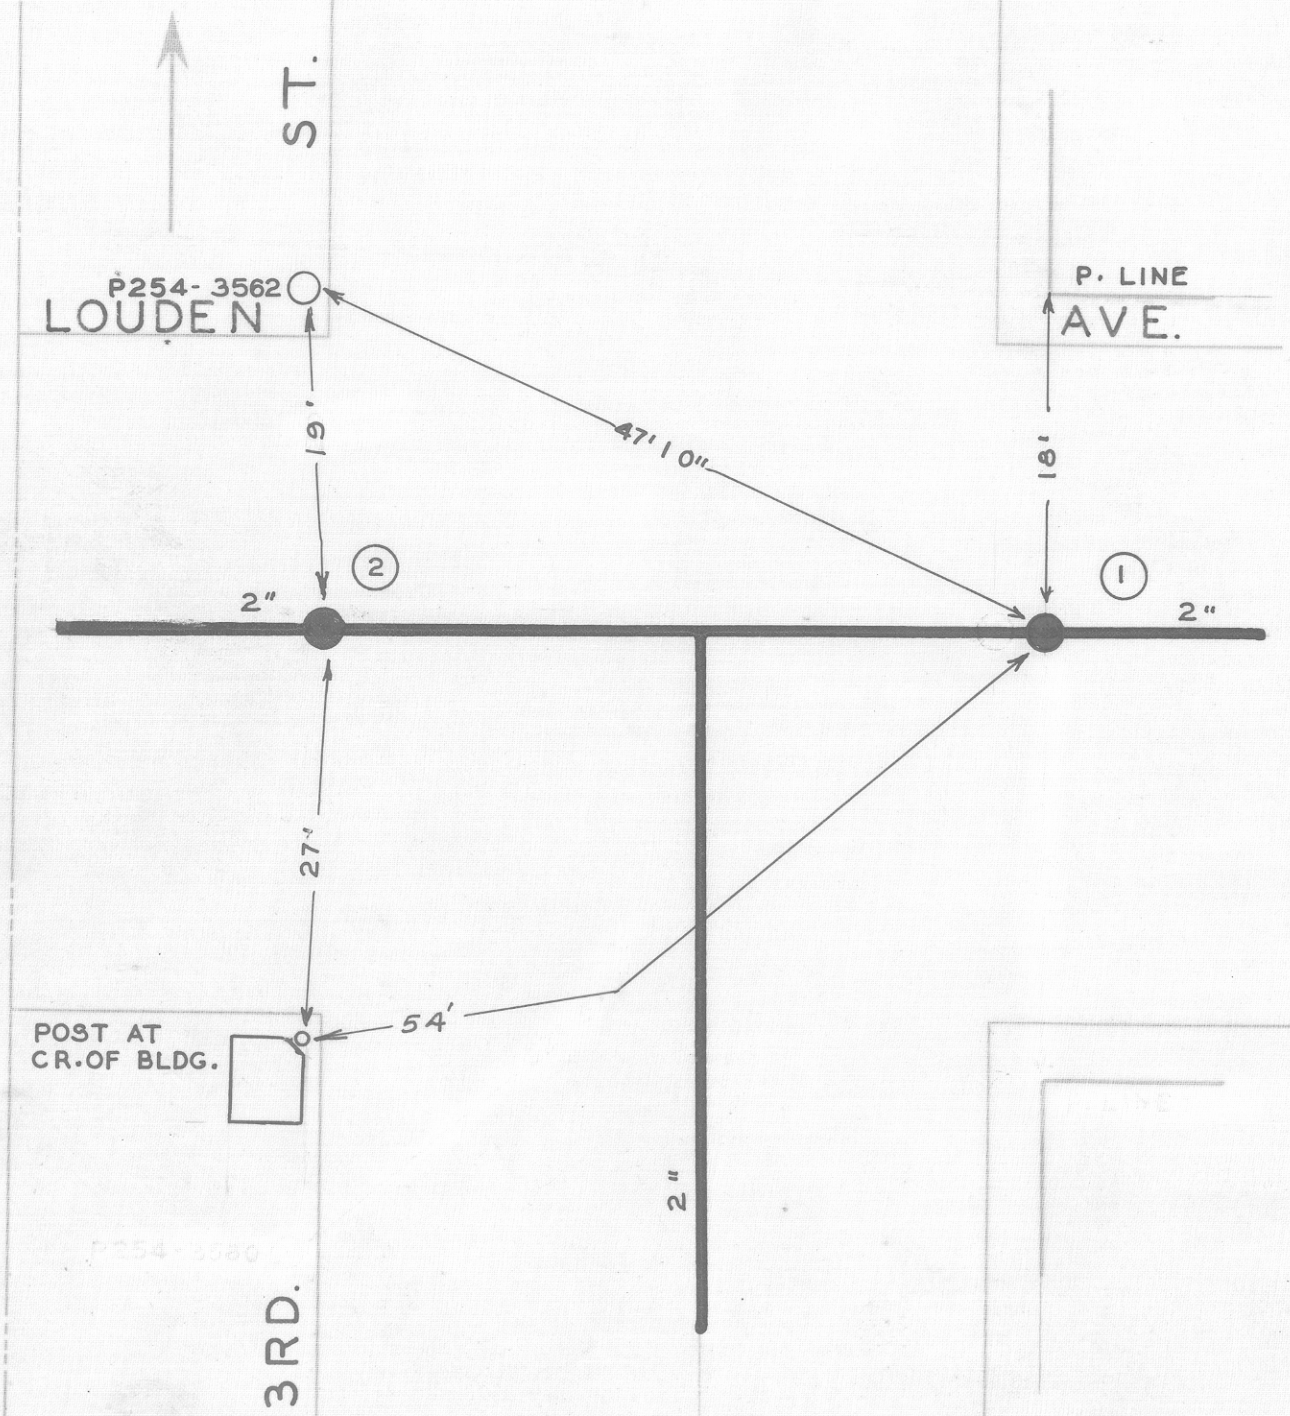

DATE	NO.	SIZE	MAKE	OPEN	TURNS
1946	1	2"	DARLING	R	7 1/2
1946	2	2"	DARLING	R	7 1/2
	1	0	EPL		
	2	3'-E	WPL		

CITY OF ROANOKE—WATER DEP'T

VALVE DIAGRAM

LOUDON AVE. & 3RD. ST.

N. W.

SEC. MAP 201

DATE 4/17/46 PAGE NO. NW278