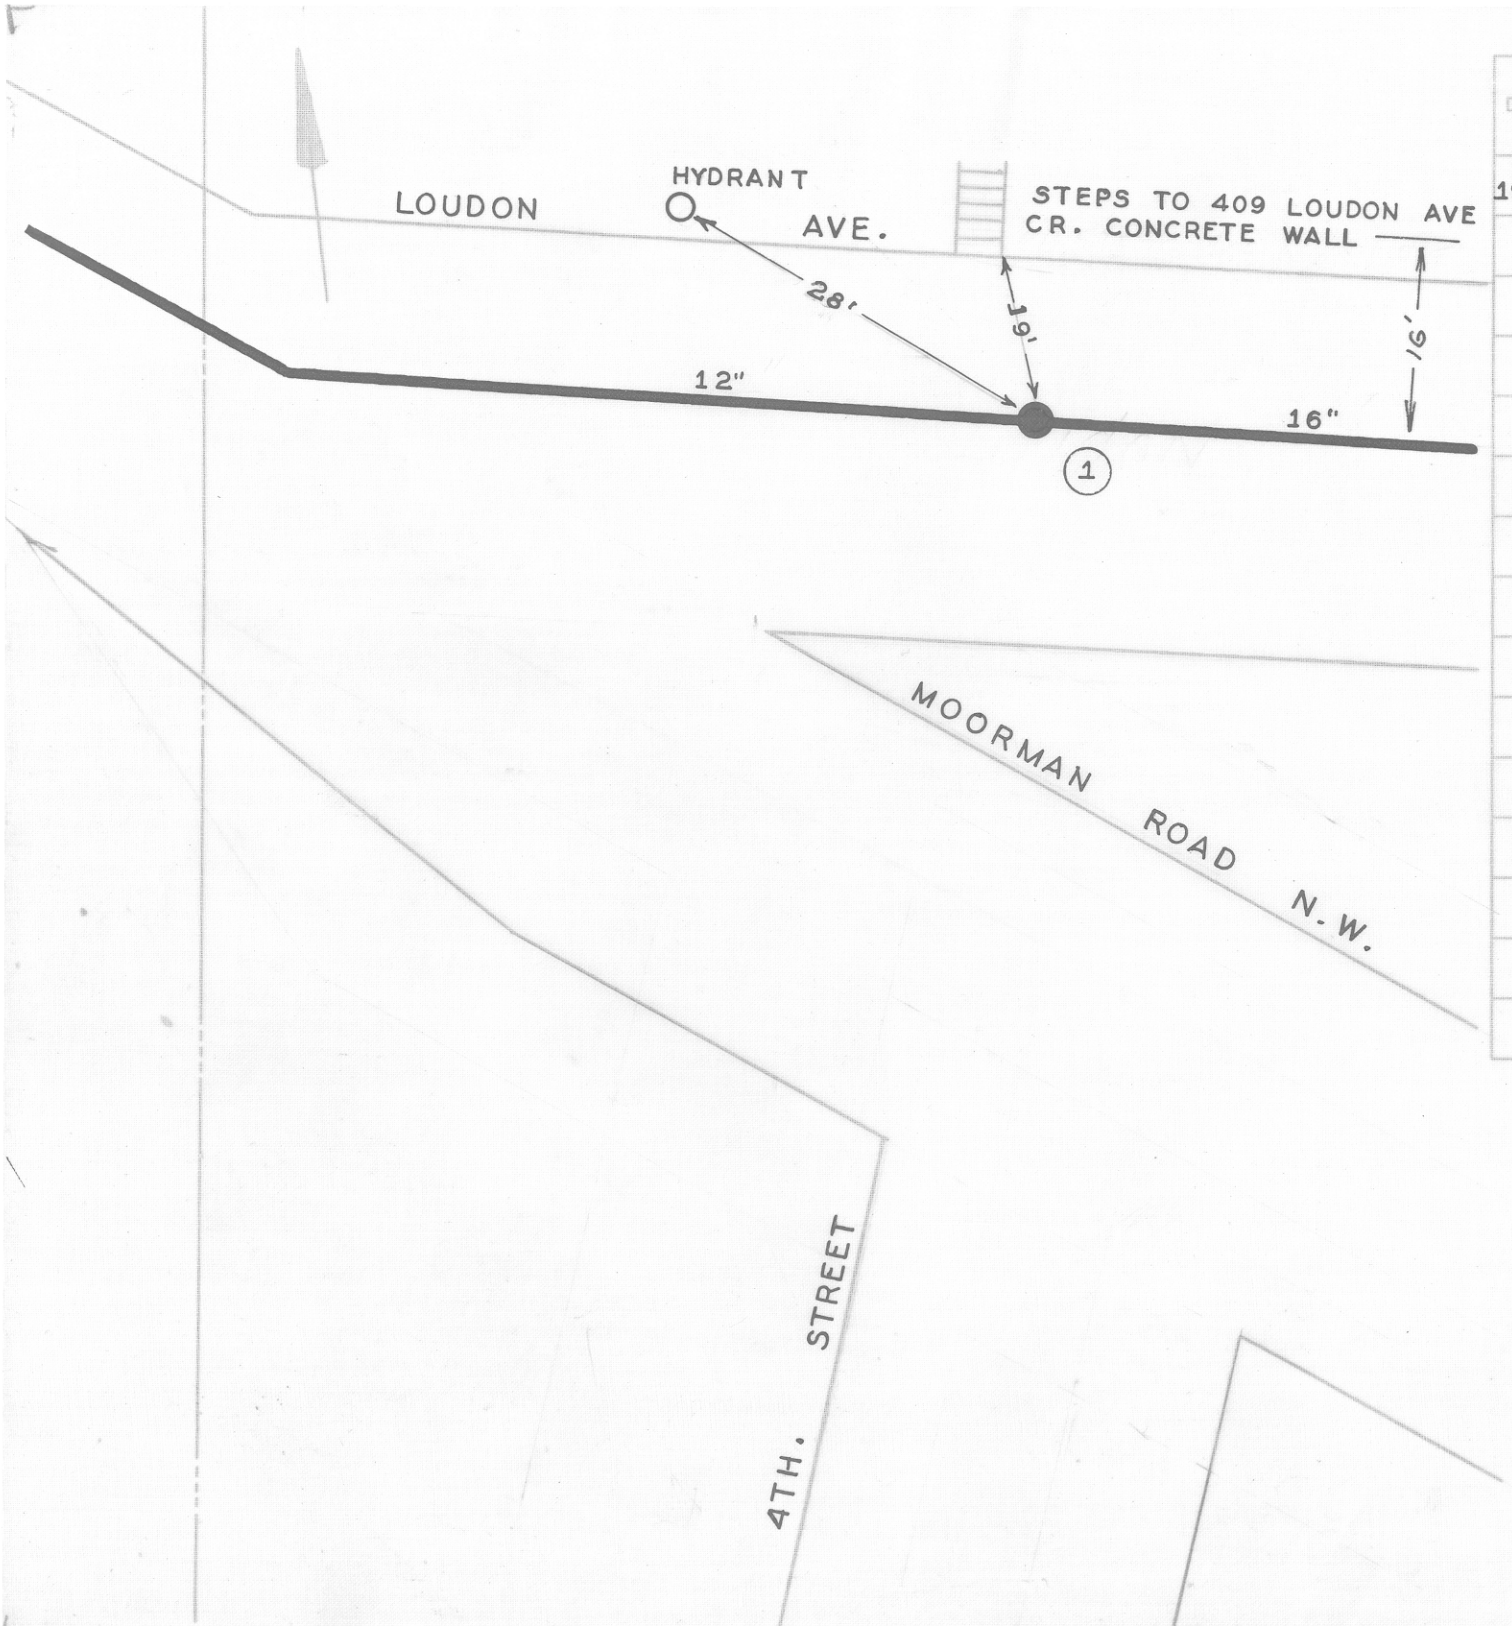

DATE	NO.	SIZE	MAKE	OPEN	TURNS
1946	1	12"	M & H.	L	26
	1	0	WPL		

CITY OF ROANOKE—WATER DEP'T

VALVE DIAGRAM

LOUDON AVENUE & 4TH STREET N. W.

SEC. MAP 201

DATE

PAGE NO. N.W. 311