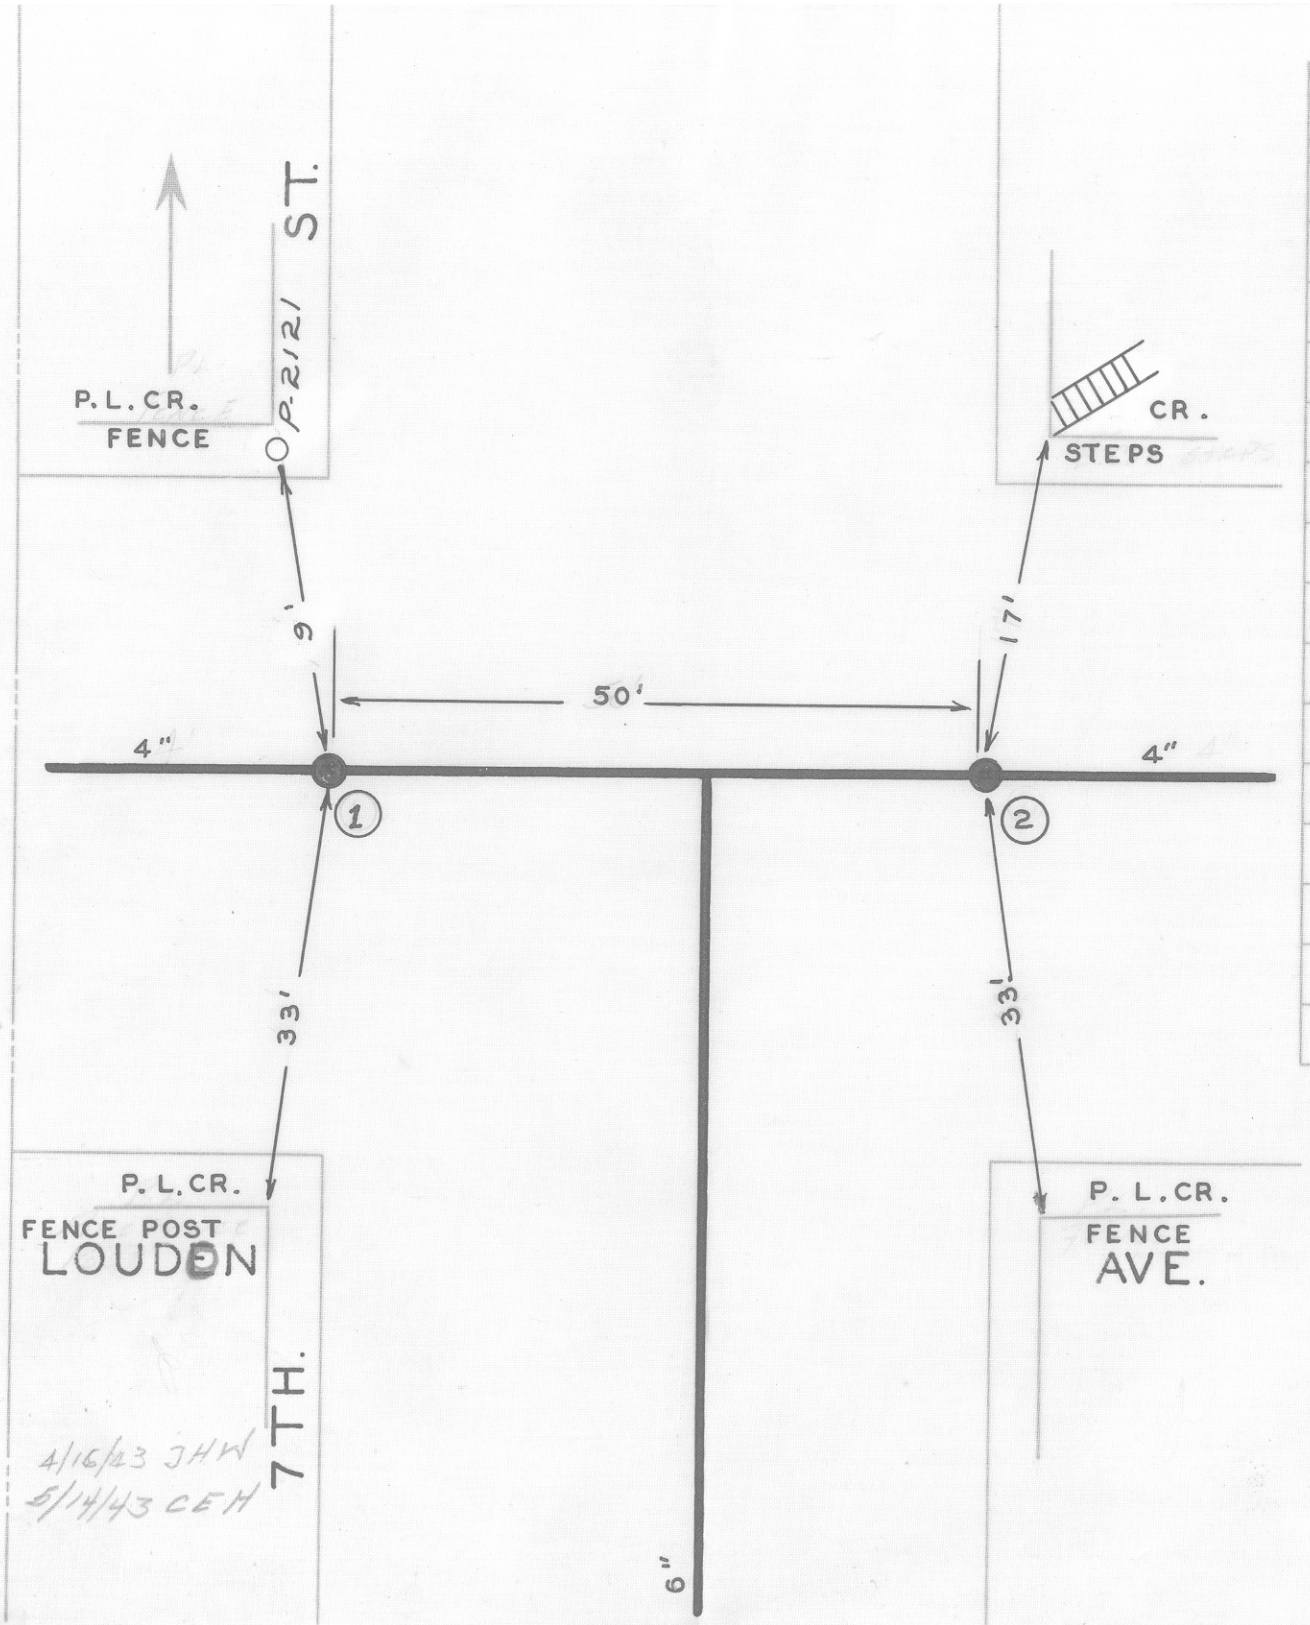

DATE	NO.	SIZE	MAKE	OPEN	TURNS
1890	1	4"		R	10
1890	2	4"		R	10
	1	0	WPL		
	2	0	EPL		

CITY OF ROANOKE—WATER DEP'T

VALVE DIAGRAM

LOUDON AVE. & 7TH. ST. N. W.

SEC. MAP 211

DATE

PAGE NO. N.W. 89