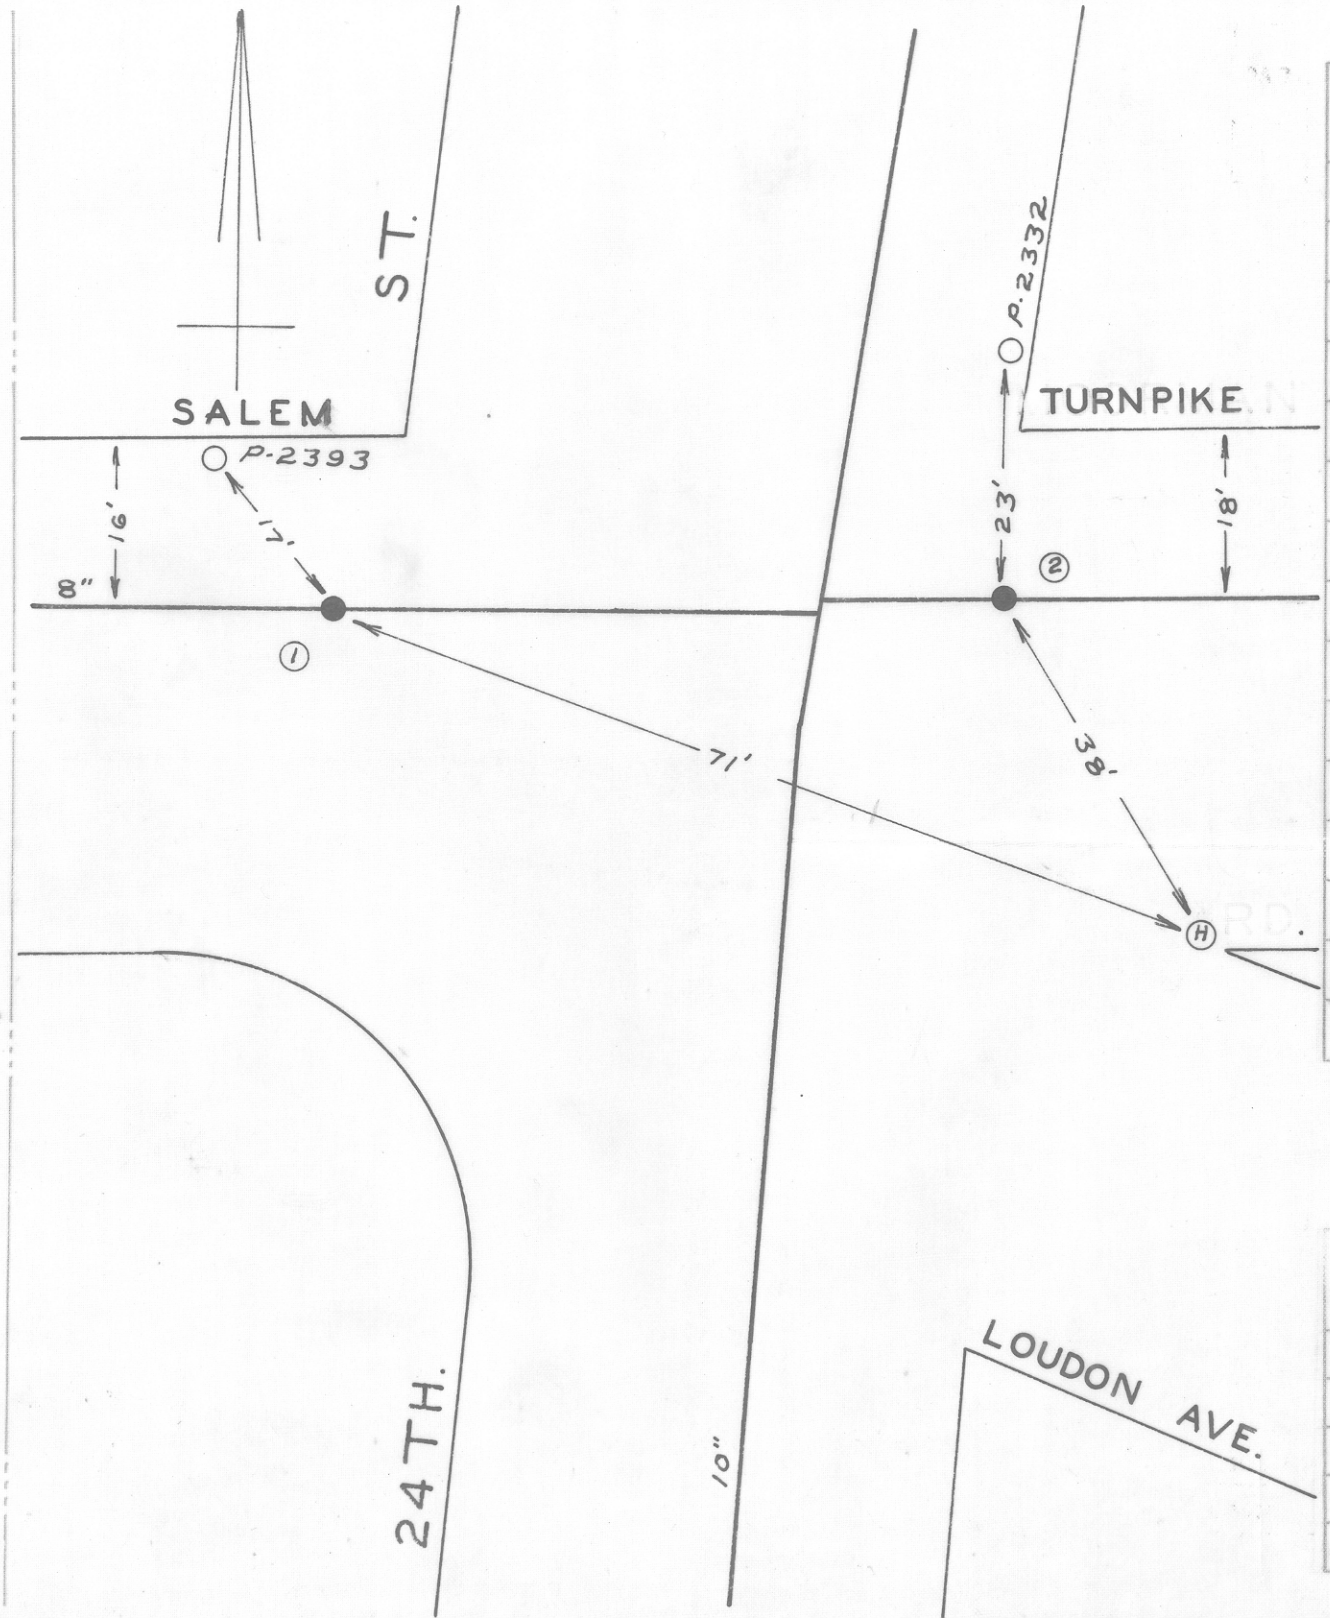

DATE	NO.	SIZE	MAKE	OPEN	TURNS
	1	8"			
	2	8"	DARLING	R	27
	1	5'-W	WPL		
	2	0	EPL		

CITY OF ROANOKE—WATER DEPT.

VALVE DIAGRAM

LOUDON AVENUE, SALEM

TURNPIKE & 24TH ST. N.W

SEC. MAP 232

DATE PAGE NO.

"IMPERIAL" TRACING CLOTH
K & E CO., N. Y.