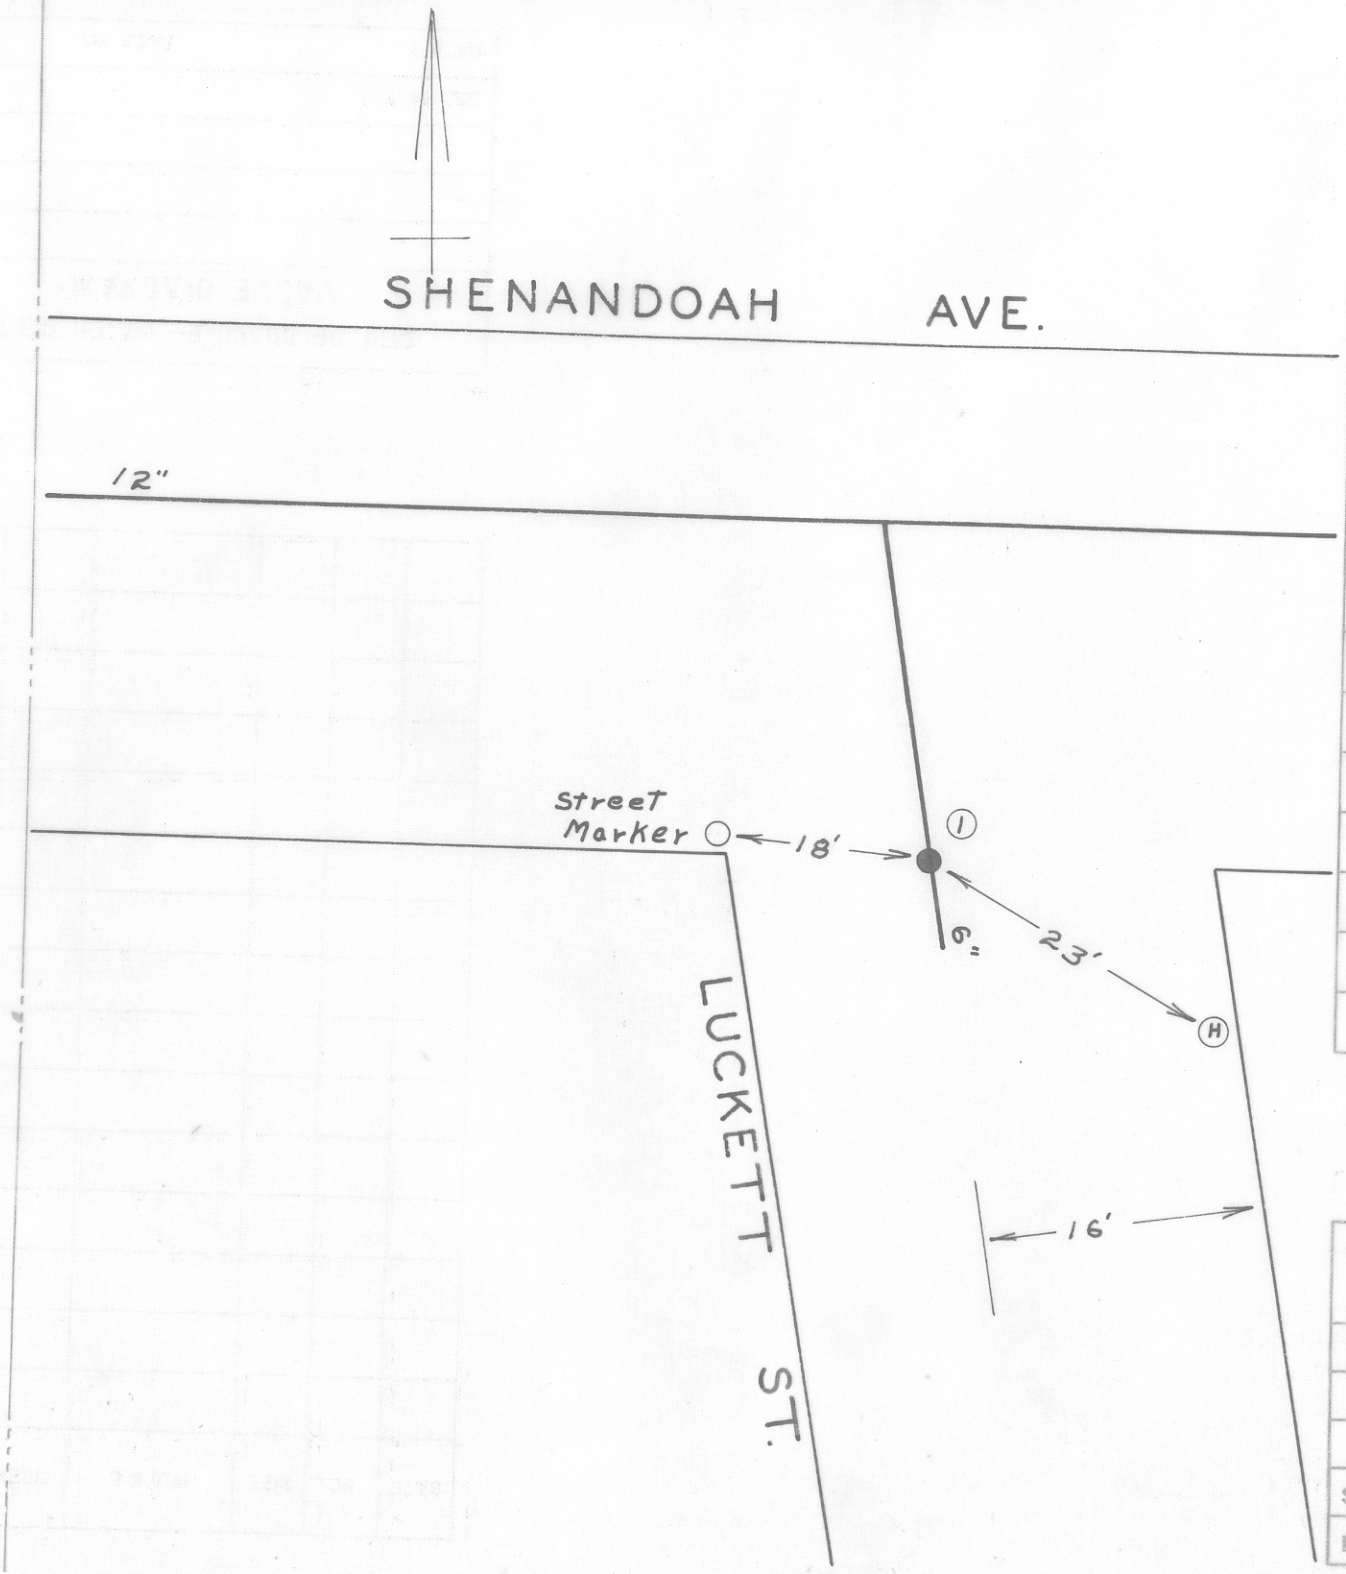

DATE	NO.	SIZE	MAKE	OPEN	TURNS
	1	6"	MUELLER	R	20
	1	0	SPL		

CITY OF ROANOKE—WATER DEPT.

VALVE DIAGRAM

LUCKETT ST. &

SHENANDOAH AVE.

SEC. MAP 263

DATE PAGE NO.

"IMPERIAL" TRACING CLOTH
K & E CO., N. Y.