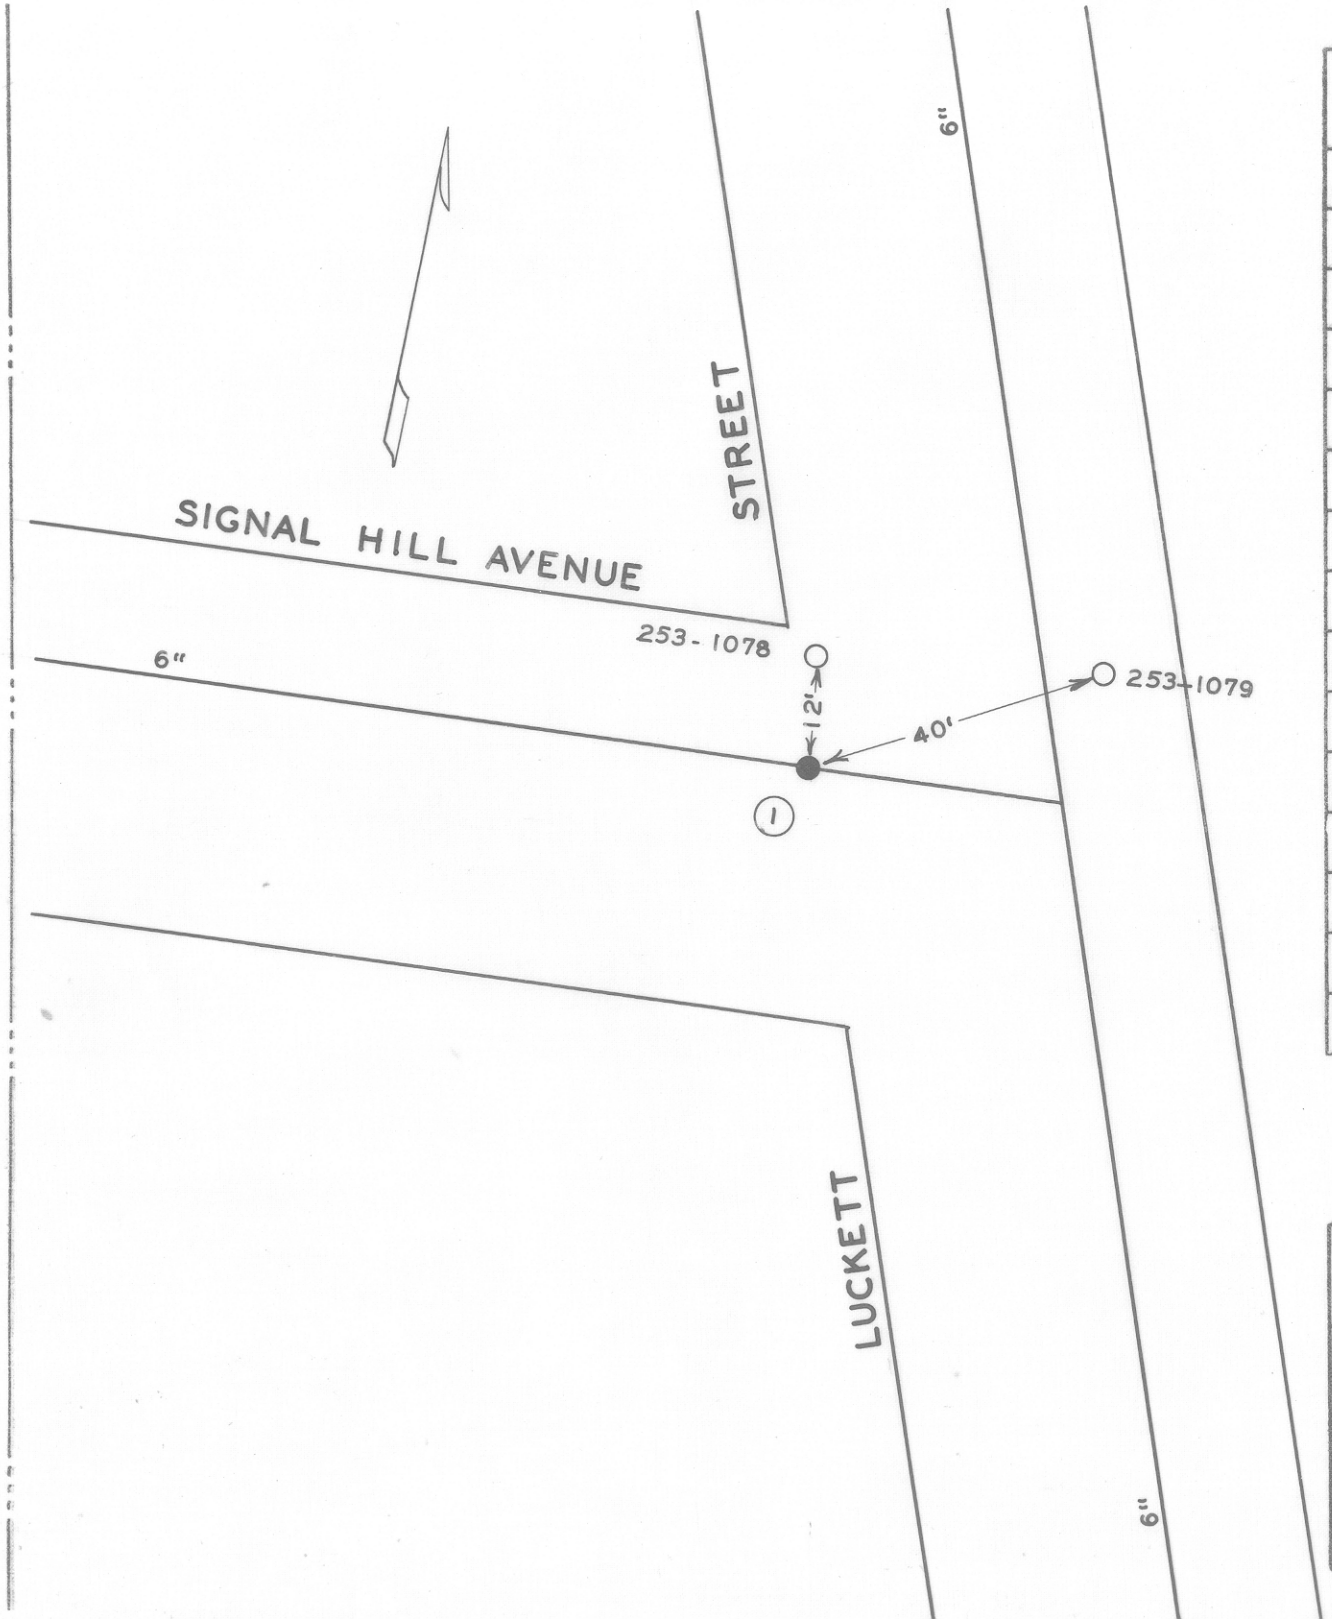

DATE	NO.	SIZE	MAKE	OPEN	TURNS
12-61	1	6"	DARLING	R	
	1	0	WPL		

CITY OF ROANOKE — WATER DEPT.

VALVE DIAGRAM

LUCKETT STREET &

SIGNAL HILL AVENUE N.W.

SEC. MAP 263

DATE PAGE NO.