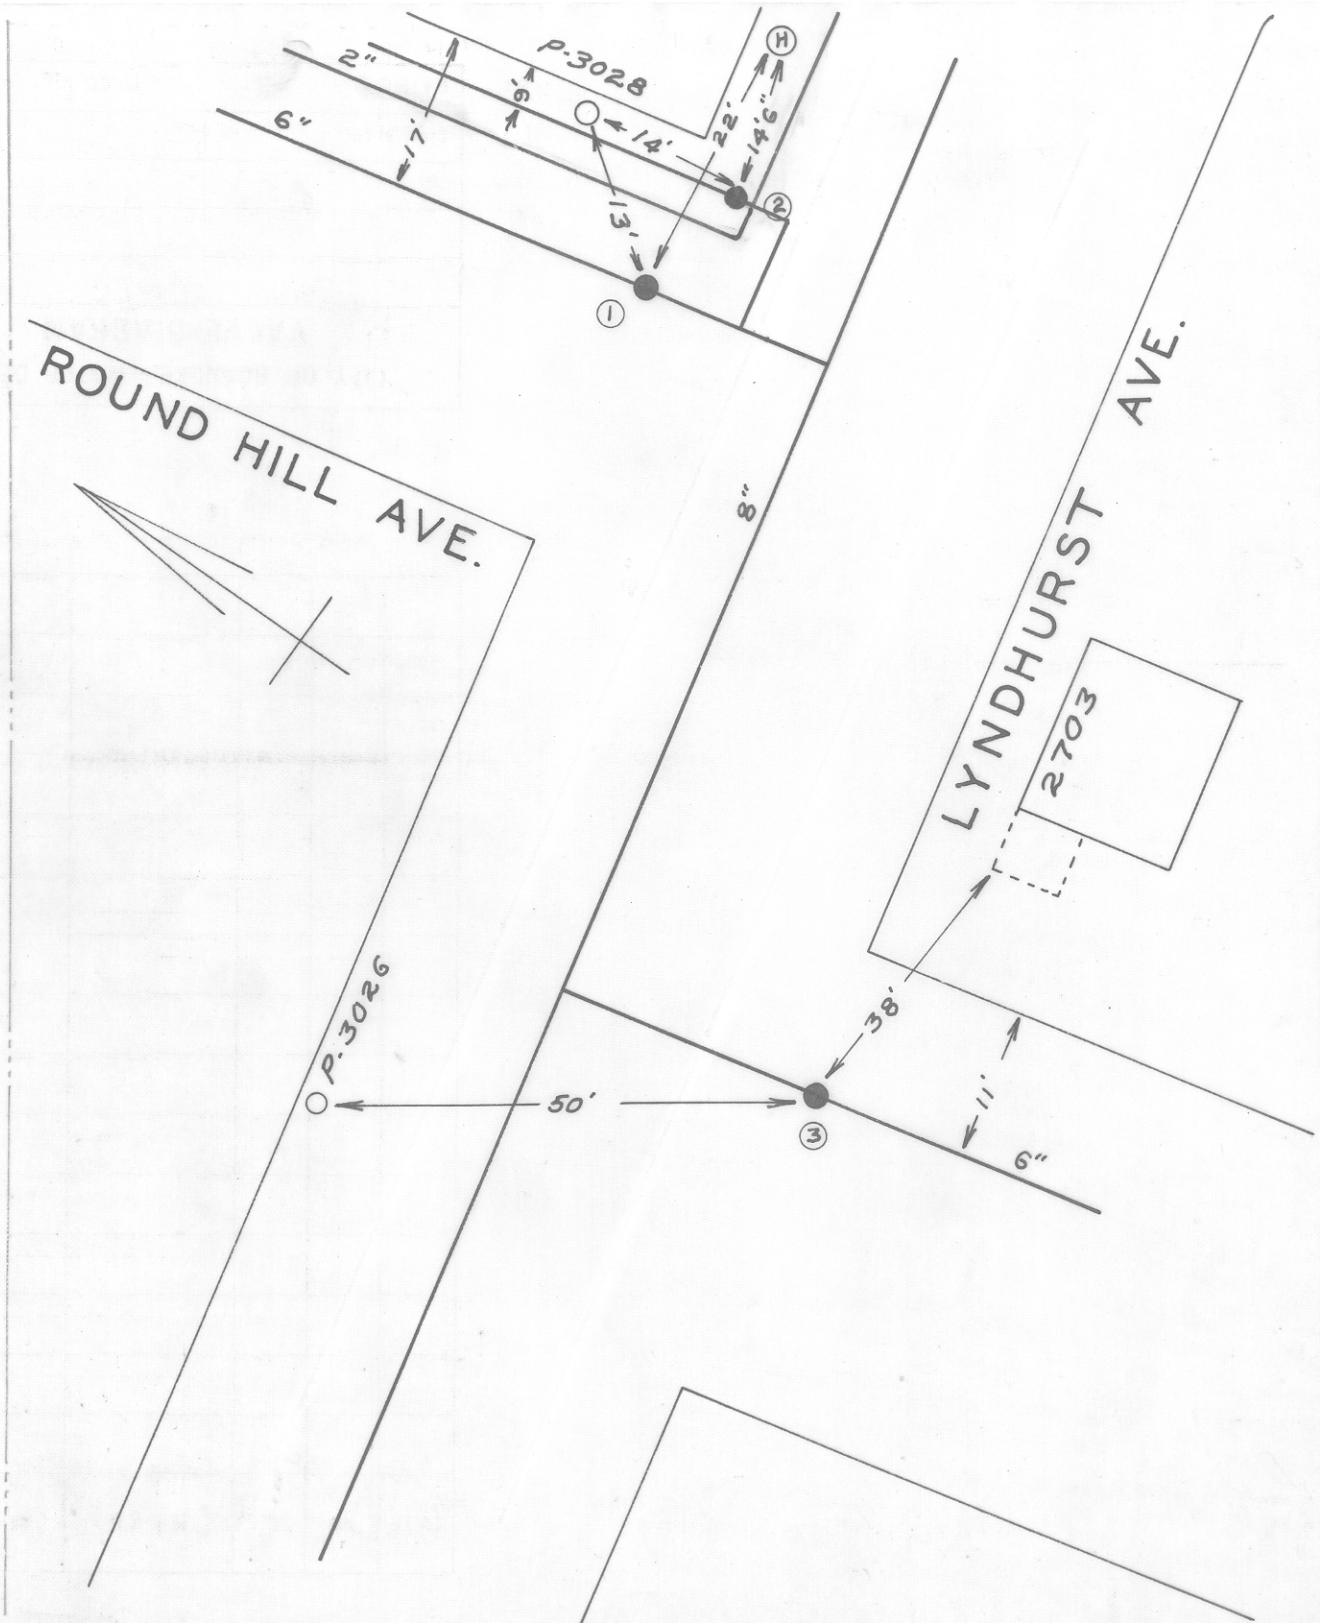

DATE	NO.	SIZE	MAKE	OPEN	TURNS
	1	6"	MUELLER	R	20
	2	2"			
	3	6"	MUELLER	R	20
	1	0	NPL		
	2	7'-S	NPL		
	3	0	SPL		

CITY OF ROANOKE—WATER DEPT.

VALVE DIAGRAM

LYNDHURST AVE. &

ROUND HILL AVE. N.W.

SEC. MAP 207

DATE PAGE NO.

"IMPERIAL" TRACING CLOTH.
K & E CO., N. Y.