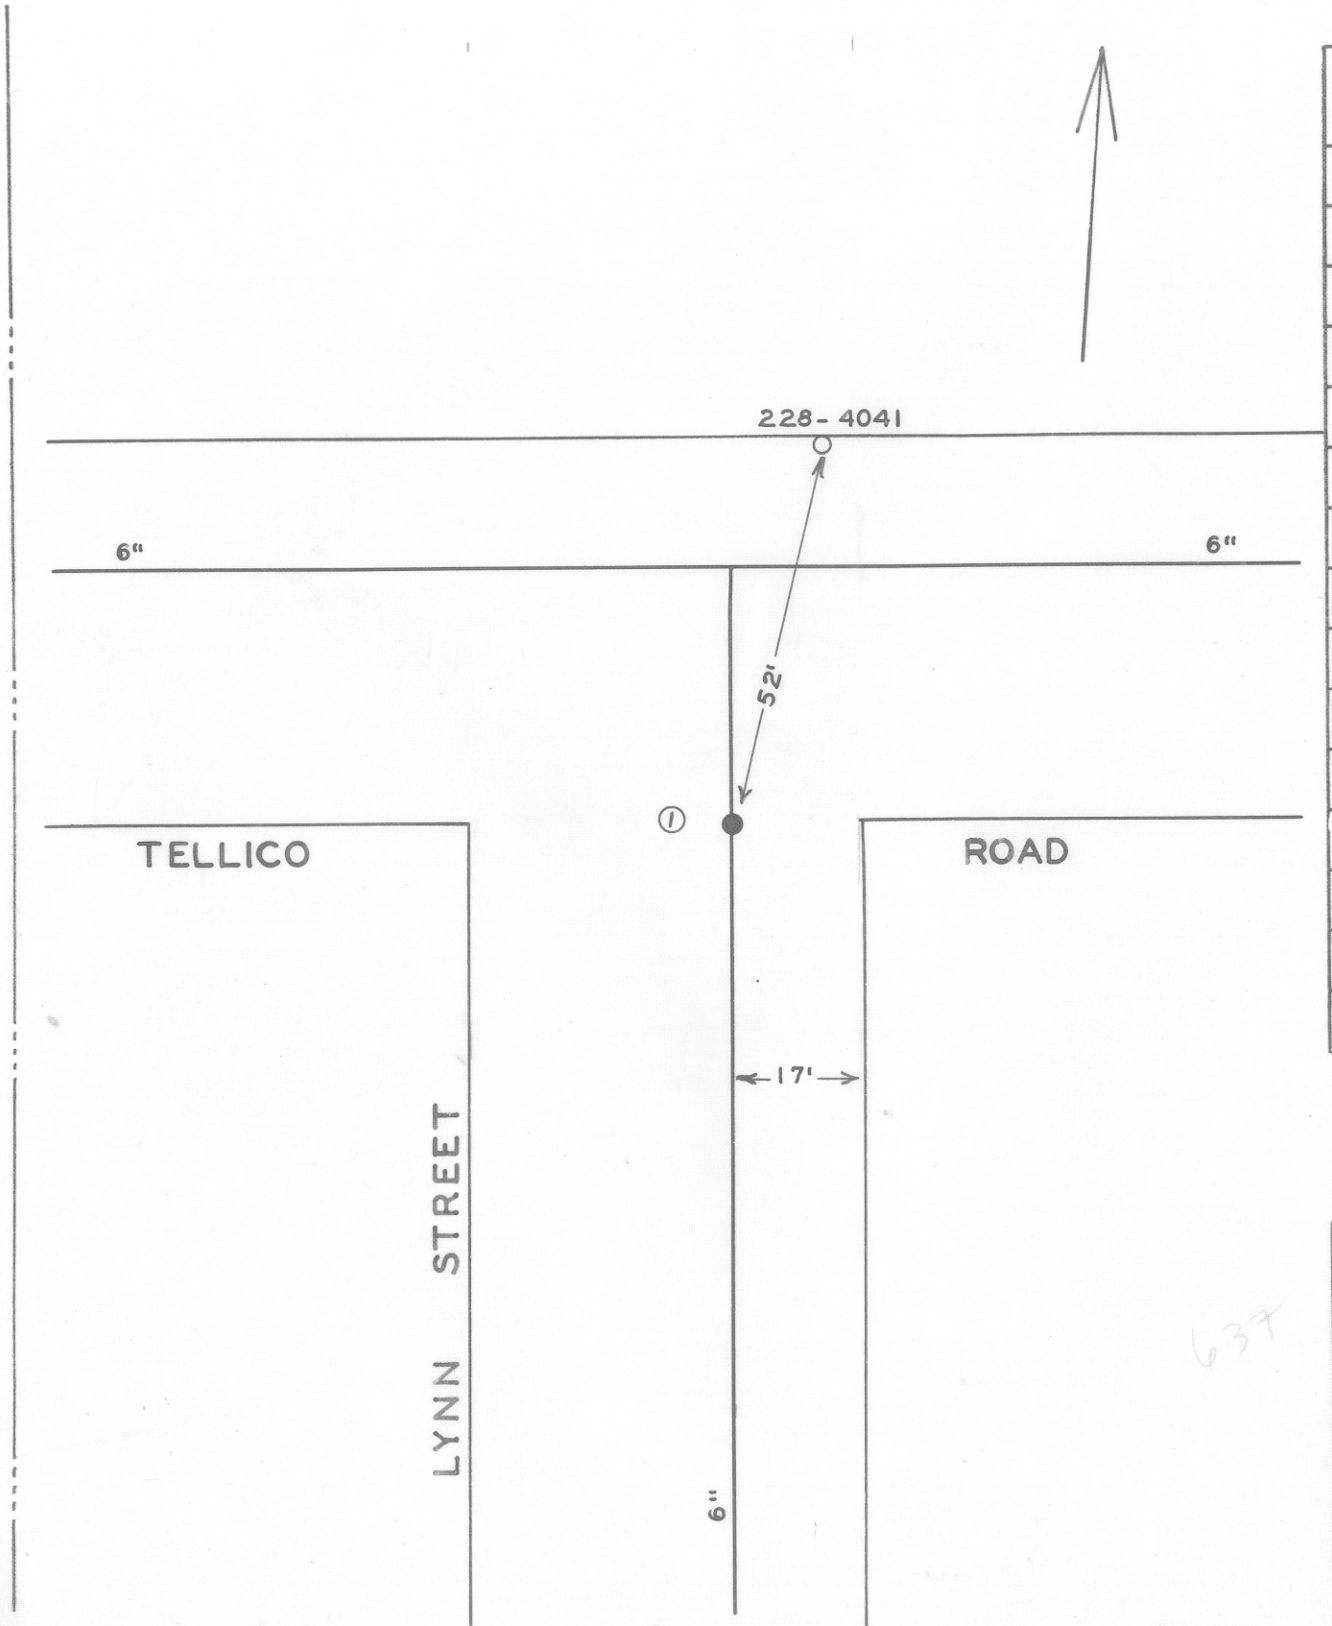

DATE	NO.	SIZE	MAKE	OPEN	TURNS
7-65	1	6	MUELLER	R	21
	1	0	S.P.L.		

637

CITY OF ROANOKE—WATER DEPT.

VALVE DIAGRAM

LYNN STREET &

TELLICO ROAD N.W.

SEC. MAP 49

DATE PAGE NO.