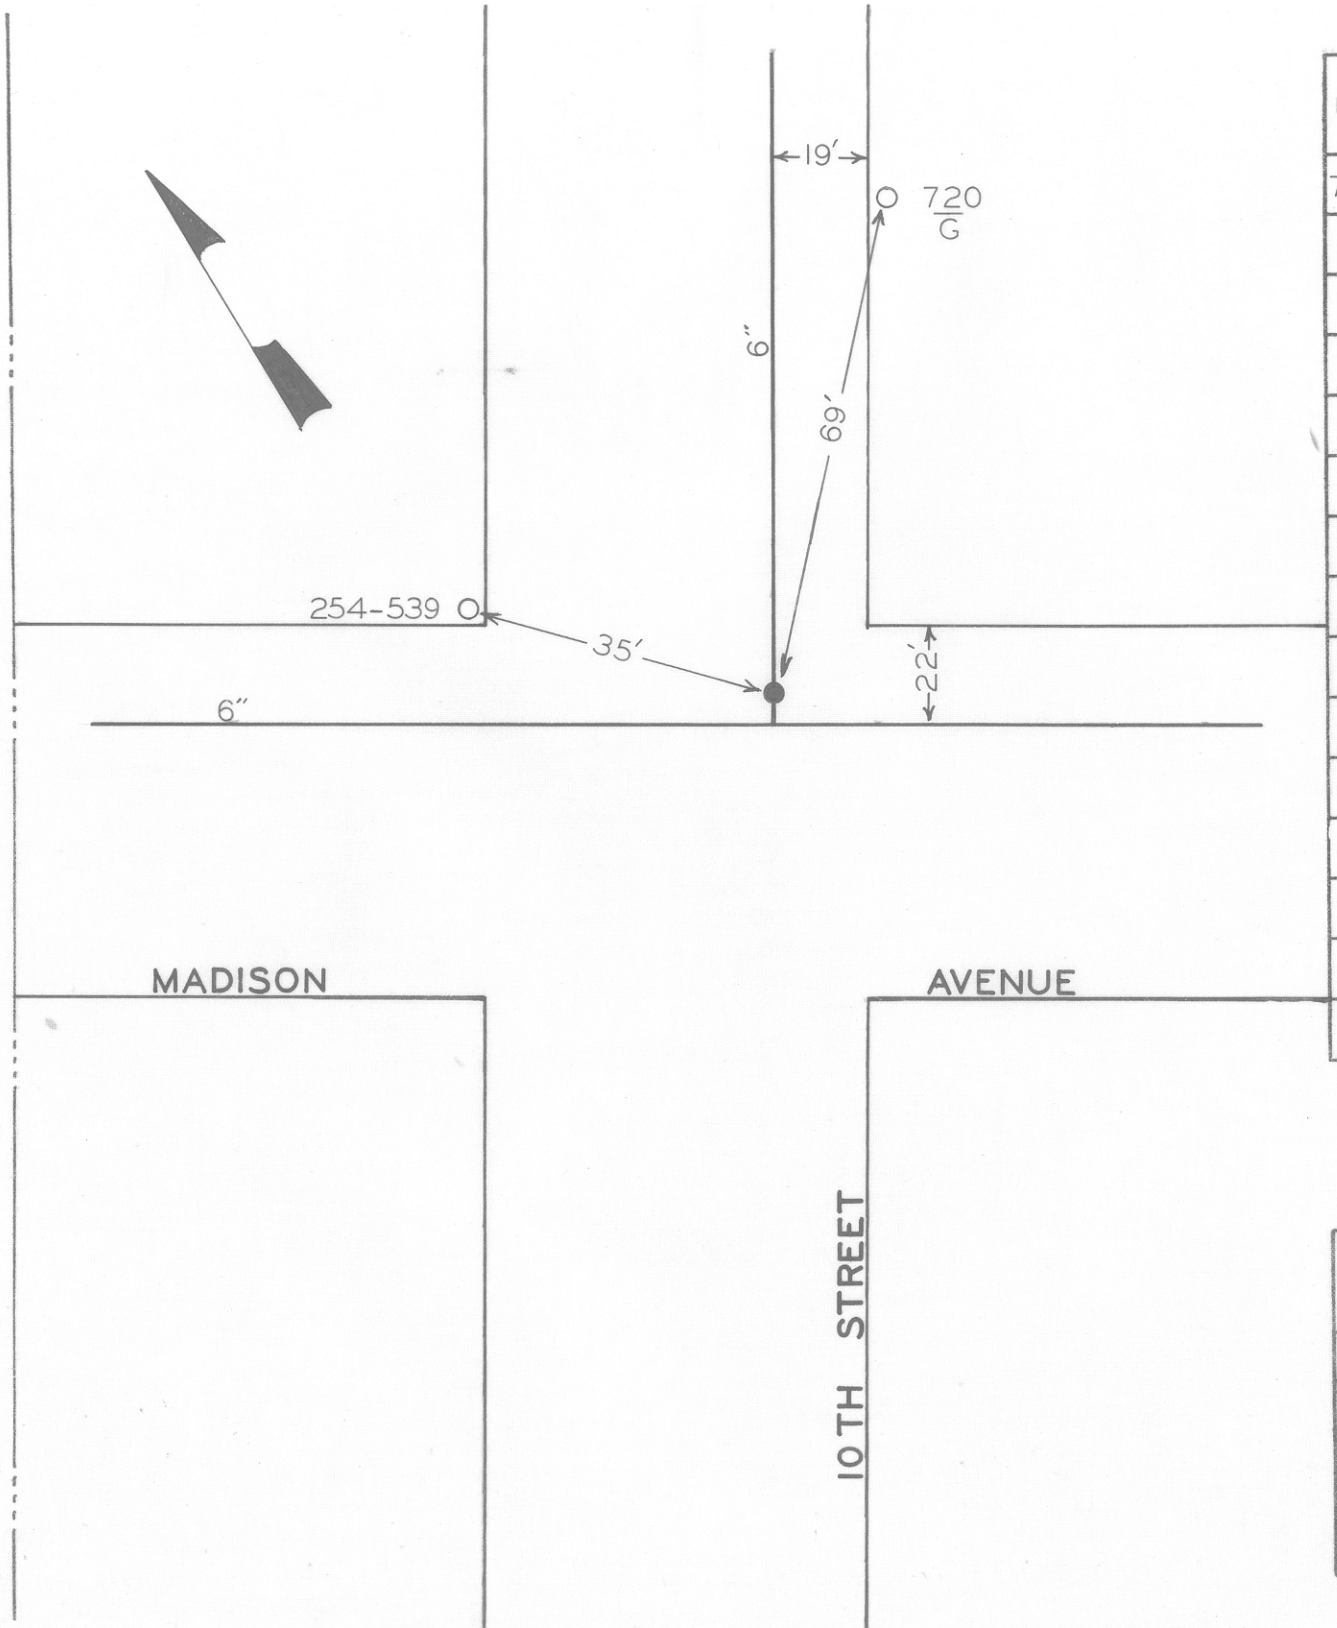

DATE	NO.	SIZE	MAKE	OPEN	TURNS
7-68	1	6"	MUELLER	R	
	1	22'	S. NPL		

CITY OF ROANOKE — WATER DEPT.

VALVE DIAGRAM

MADISON AVE. & 10TH ST. N.W.

SEC. MAP 212

DATE PAGE NO.