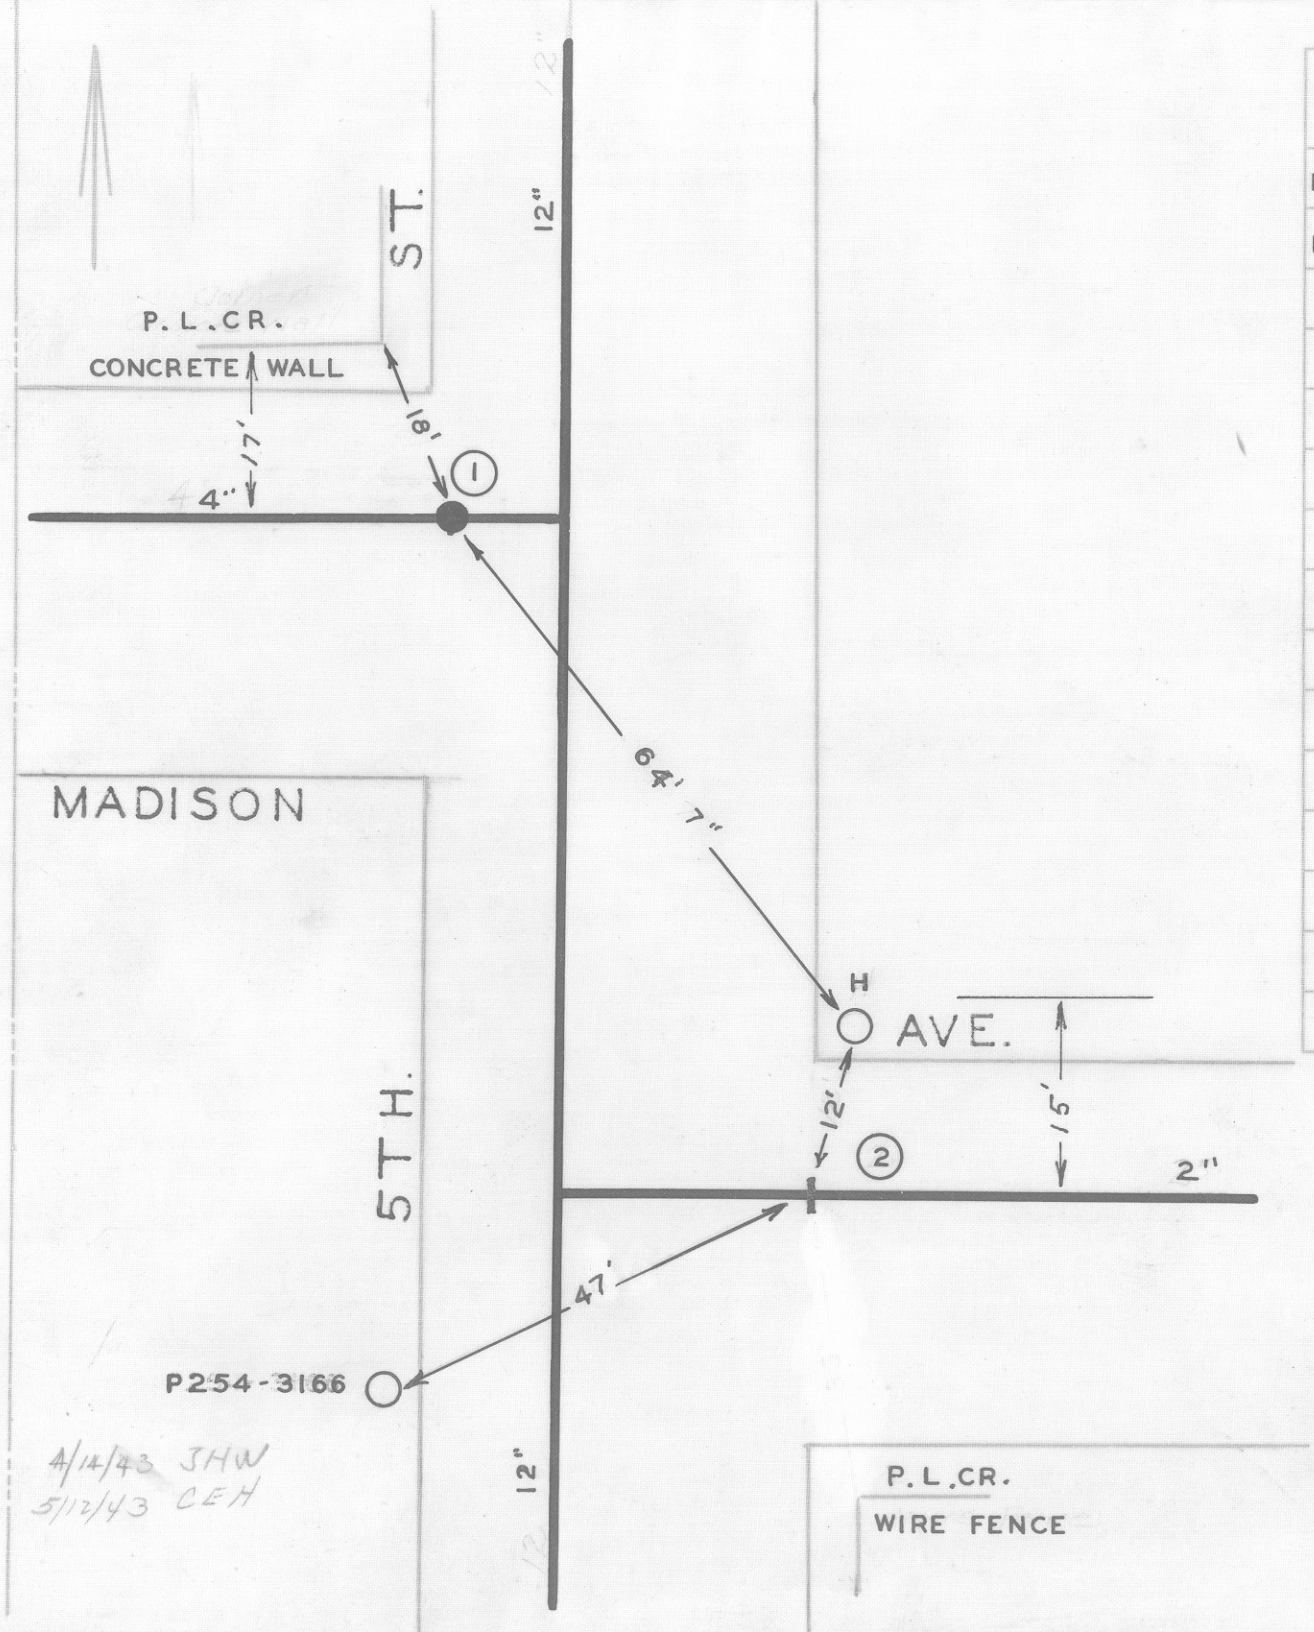

4/14/43 JHW
5/12/43 CEH

DATE	NO.	SIZE	MAKE	OPEN	TURNS
1907	1	4"		R	9
1907	2	2"		L	8
	1	6'-E	WPL		
	2	6'-W	EPL		

CITY OF ROANOKE—WATER DEP'T

VALVE DIAGRAM

MADISON AVE. & 5TH. ST. N. W.

SEC. MAP 202

DATE

PAGE NO N.W. 40