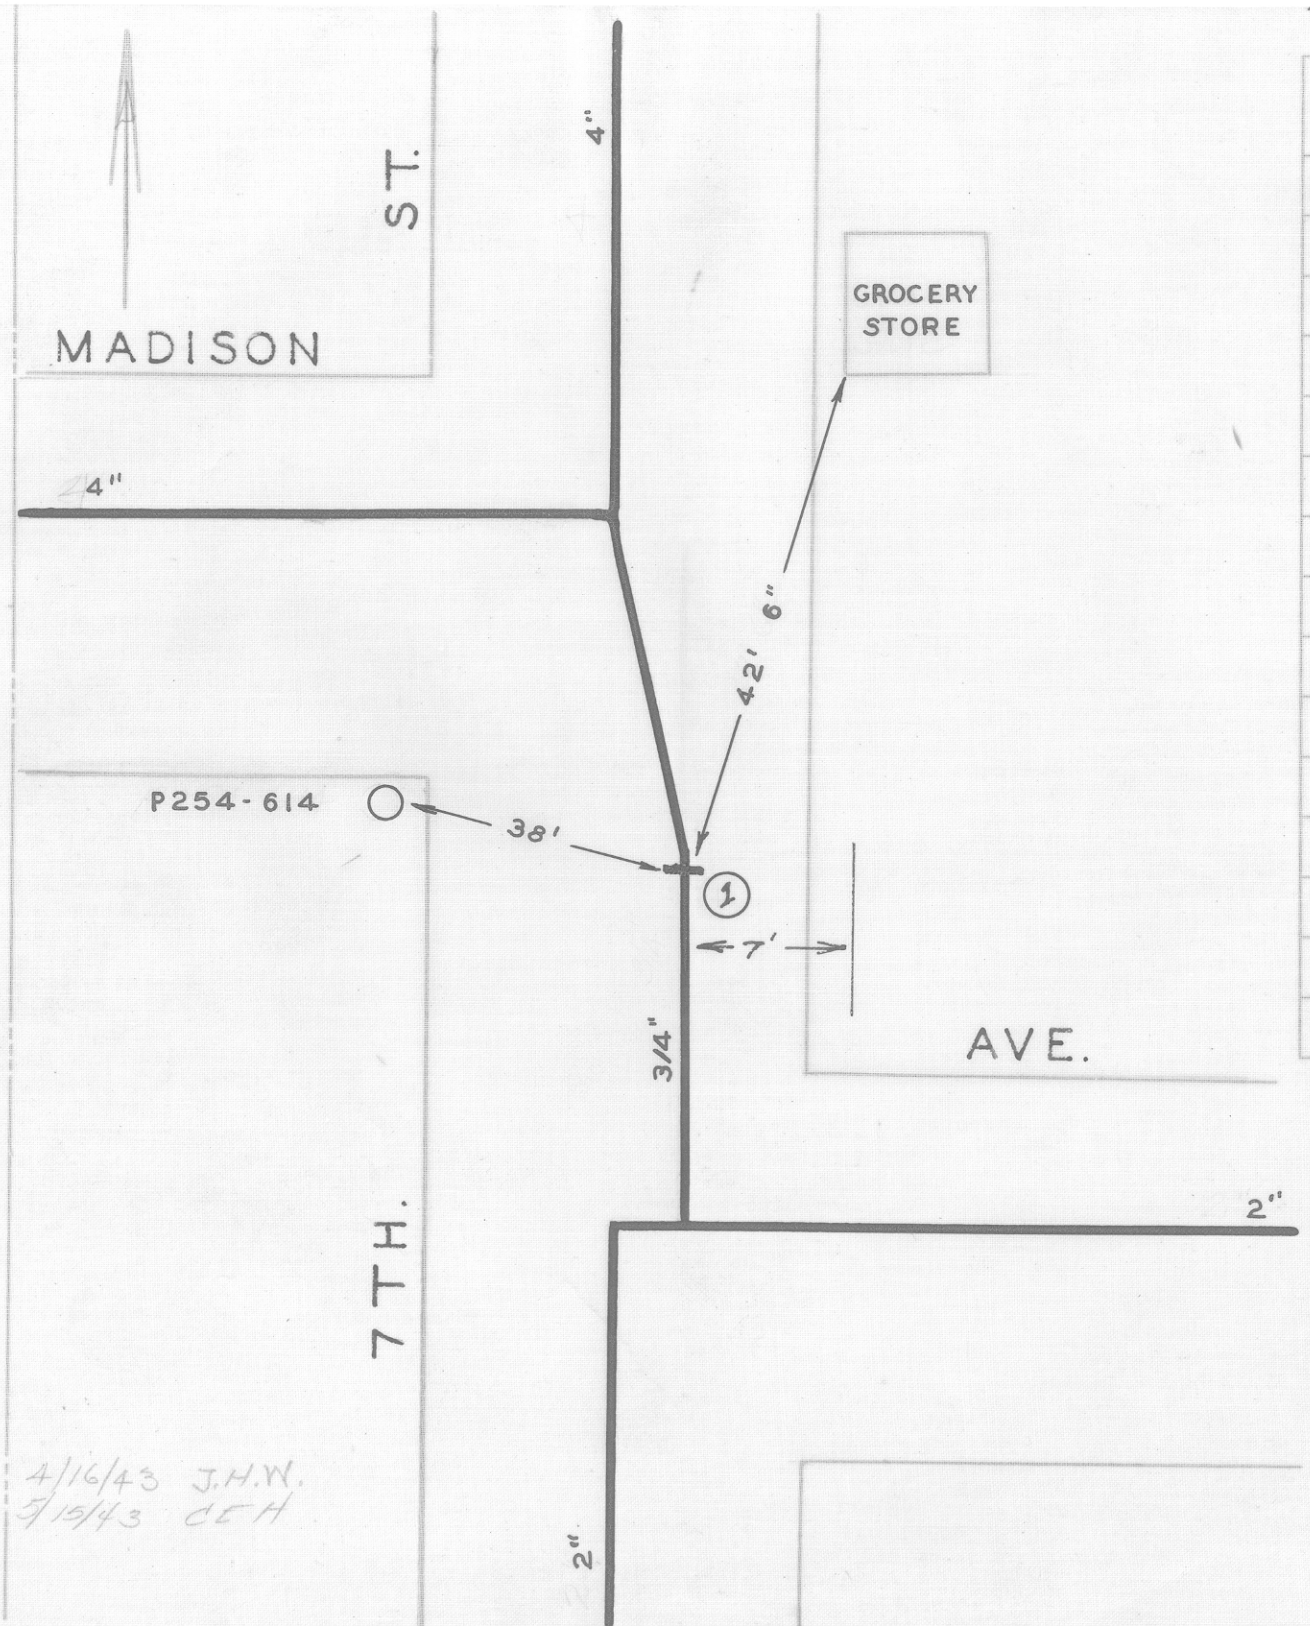

DATE	NO.	SIZE	MAKE	OPEN	TURNS
1910	1	3/4"	CURB COCK		
	1	3'-N	SPL		

CITY OF ROANOKE—WATER DEP'T

VALVE DIAGRAM

MADISON AVE. & 7TH. ST. N.W.

SEC. MAP 212

DATE

PAGE NO. NW 106