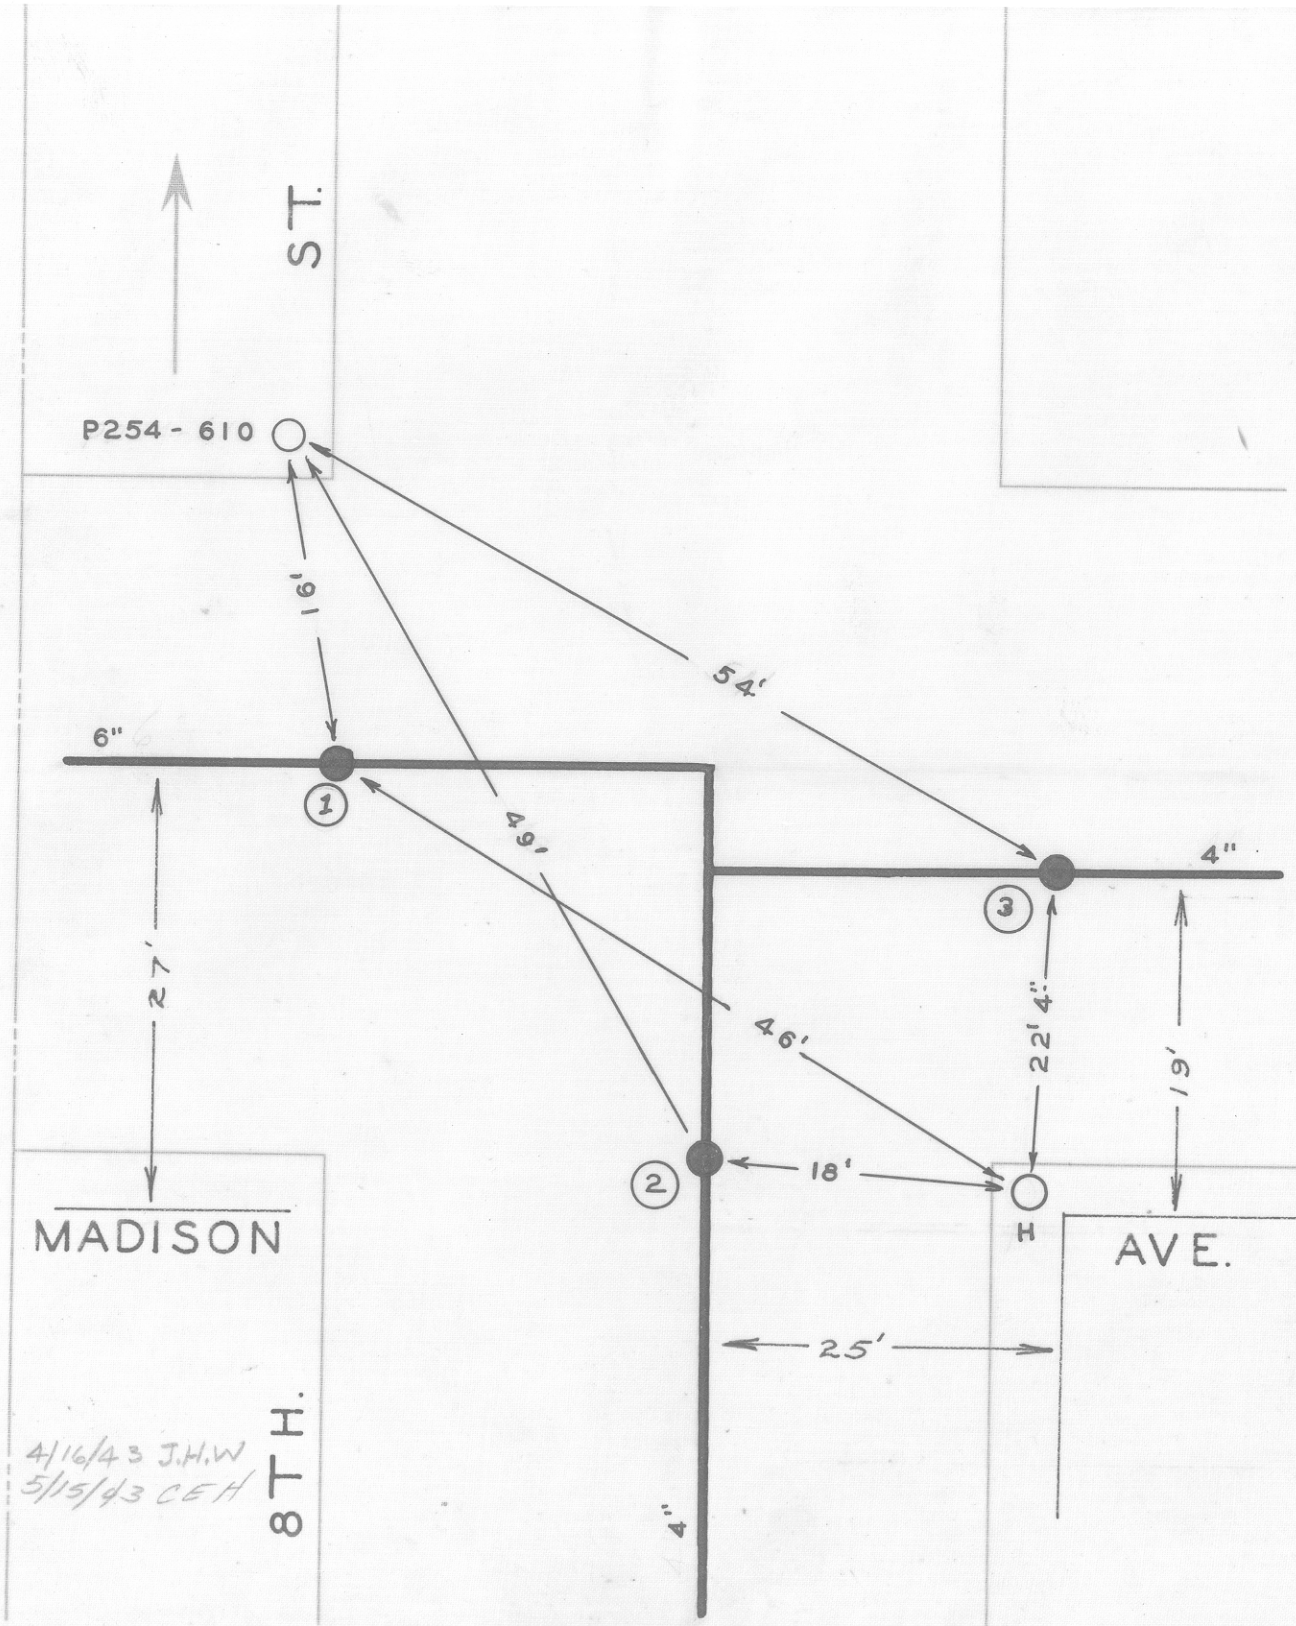

DATE	NO.	SIZE	MAKE	OPEN	TURNS
1912	1	6"		R	12
1910	2	6"		R	21
1890	3	6"		R	20 1/2
	1	3'-E	WPL		
	2	0	SPL		
	3	0	EPL		

CITY OF ROANOKE—WATER DEP'T

VALVE DIAGRAM

MADISON AVE. & 8TH. ST. N.W.

SEC. MAP 212

DATE

PAGE NO N.W.107