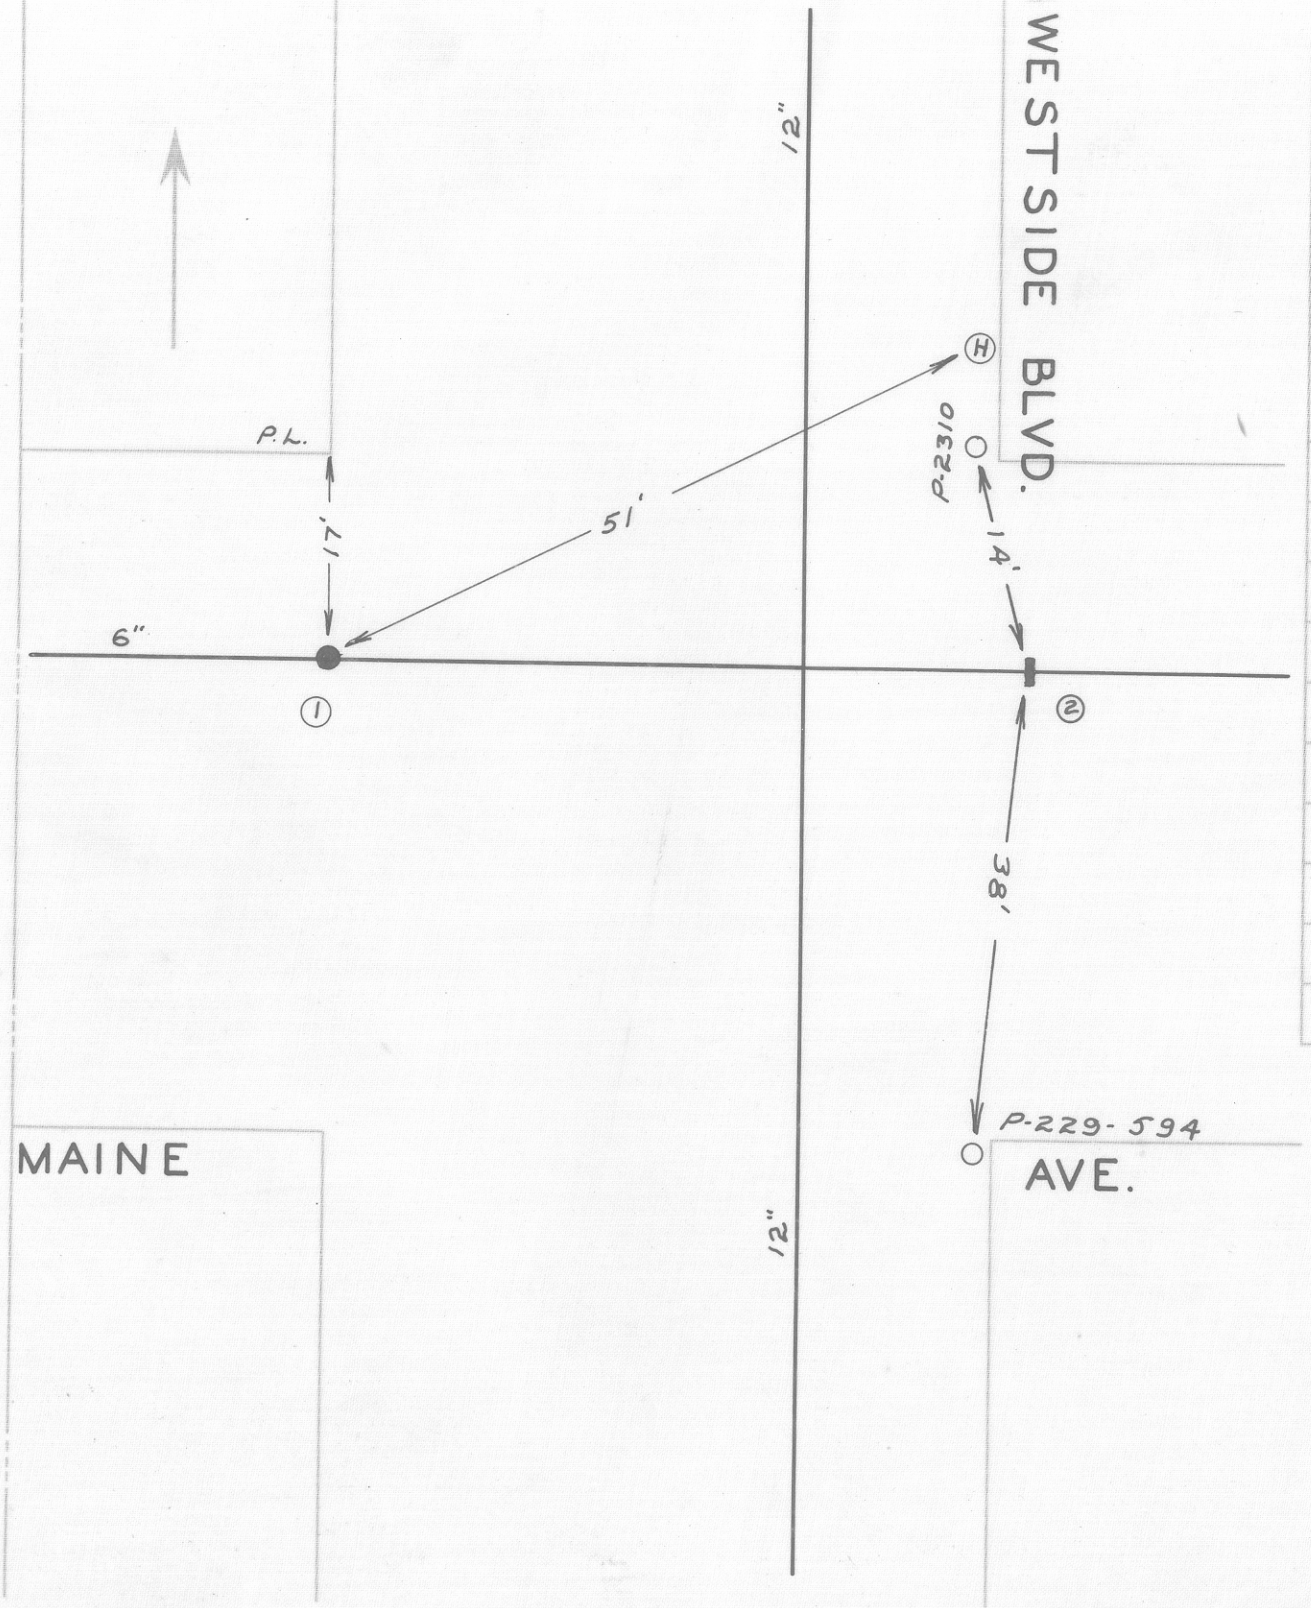

DATE	NO.	SIZE	MAKE	OPEN	TURNS
	1	6"	MUELLER	R	21
	2	2"			
	1	0	WPL		
	2	0	EPL		

CITY OF ROANOKE—WATER DEP'T

VALVE DIAGRAM

MAINE AVE. & WEST-SIDE BLVD. N.W.

SEC. MAP 267

DATE PAGE NO.