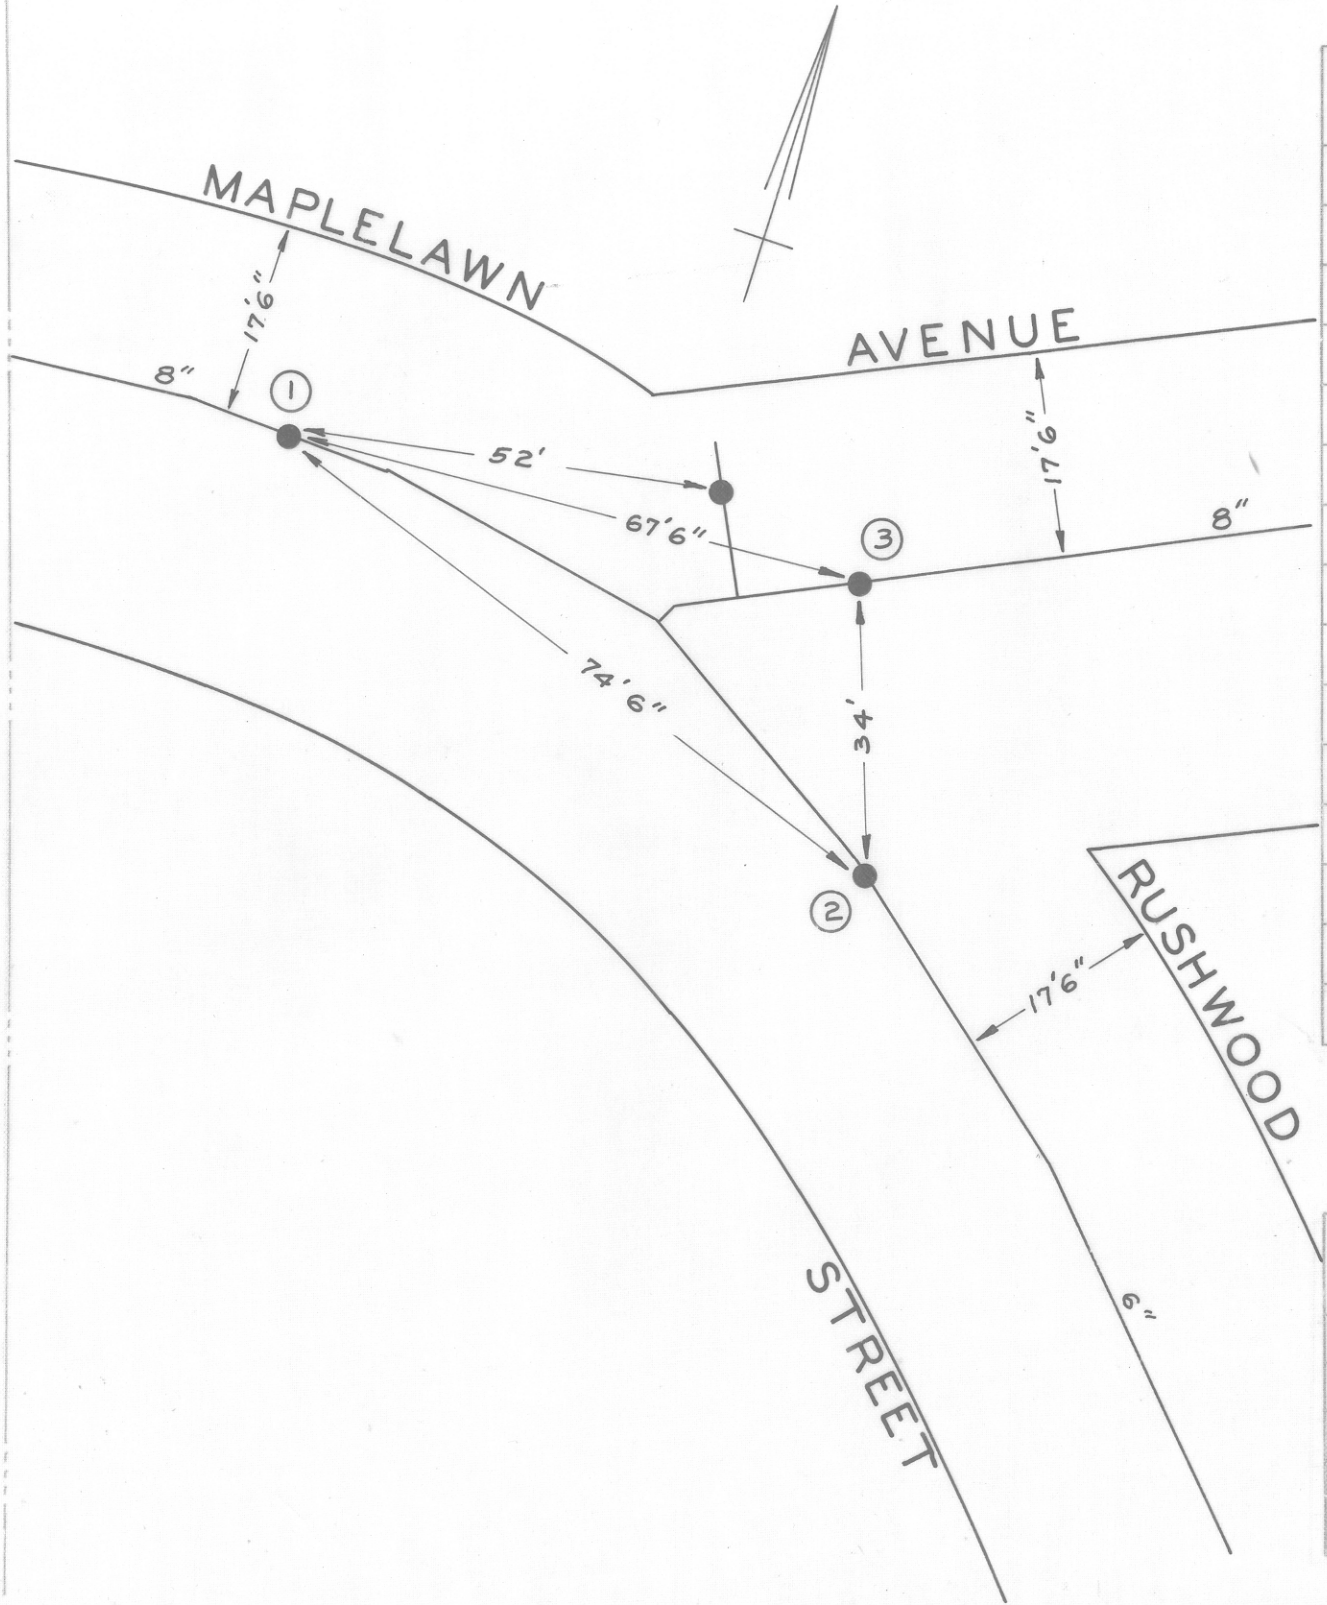

DATE	NO.	SIZE	MAKE	OPEN	TURNS
'59	1	8"	DARLING	R	26
'59	2	6"	MUELLER	R	20
'59	3	8"	DARLING	R	26
	1	0	NPL		
	2	0	SPL		
	3	0	EPL		

CITY OF ROANOKE — WATER DEPT.

VALVE DIAGRAM

MAPLELAWN AVE. &

RUSHWOOD ST. N.W.

SEC. MAP 218

DATE PAGE NO.

"IMPERIAL" TRACING CLOTH
K & E CO., N. Y.