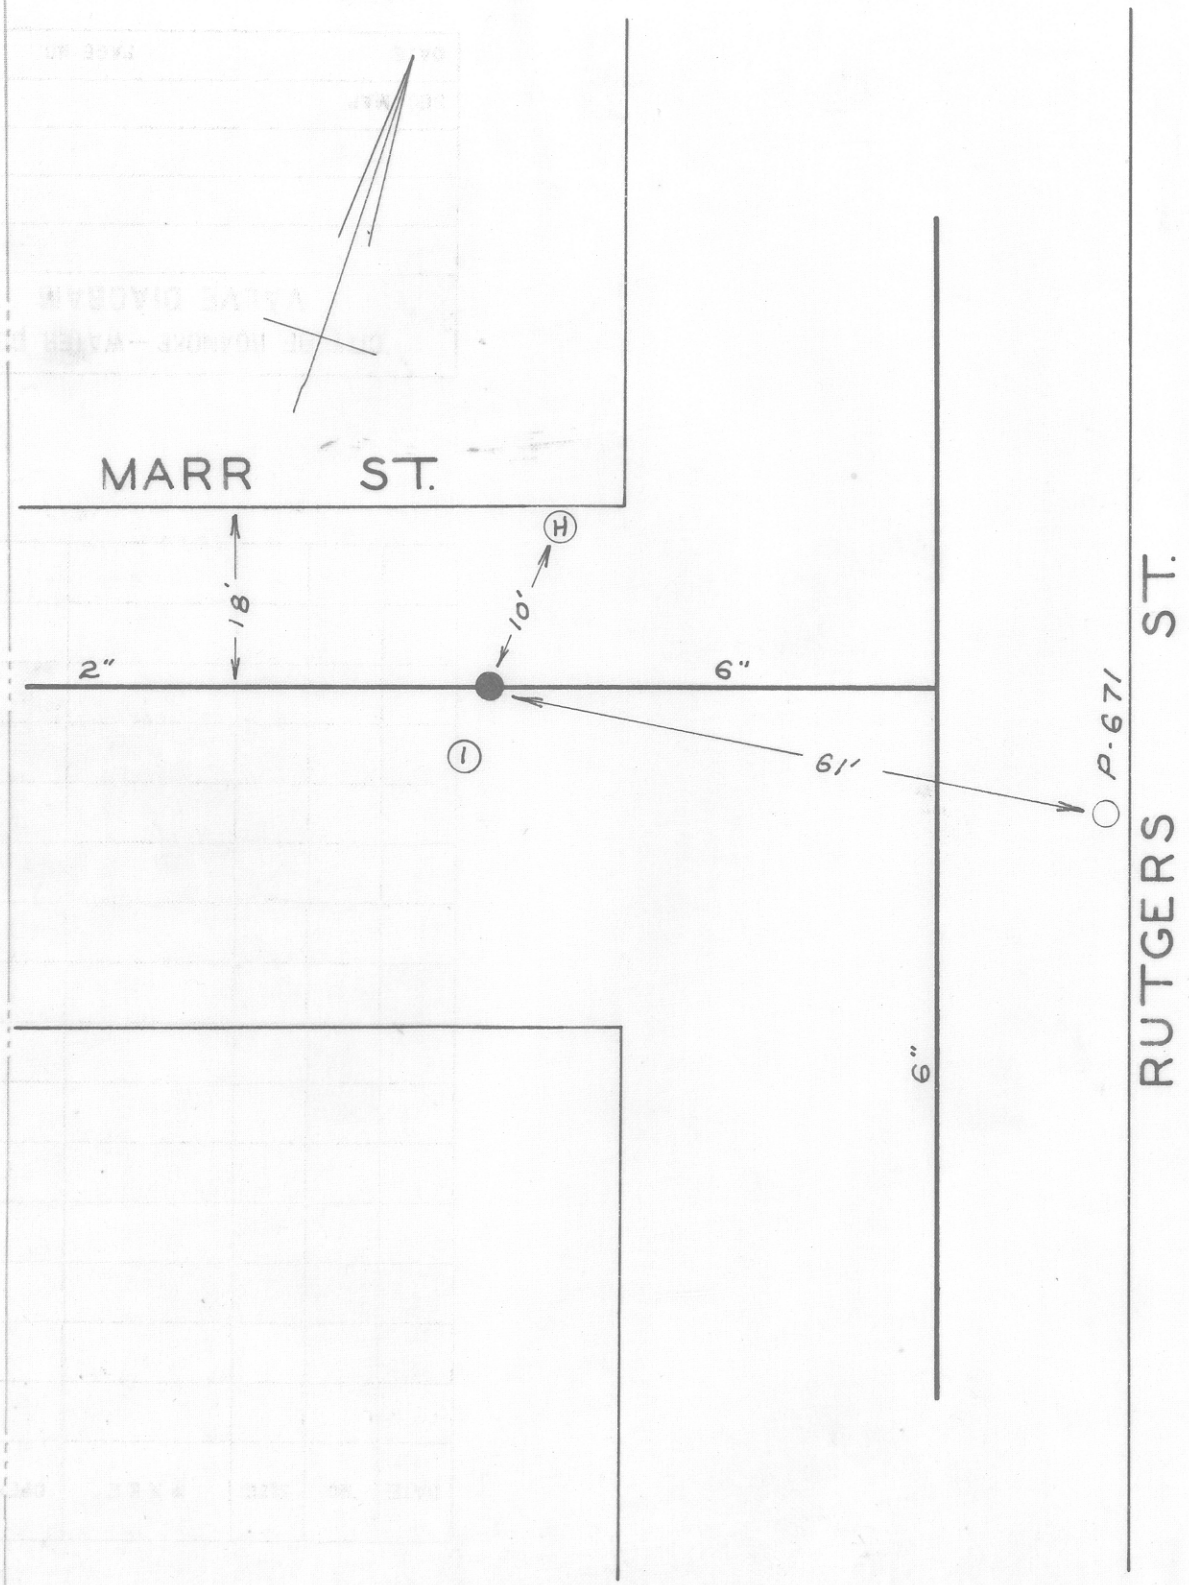

DATE	NO.	SIZE	MAKE	OPEN	TURNS
	1	2"	DARLING	R	7
	1	18'-W	WPL		

CITY OF ROANOKE—WATER DEPT.

VALVE DIAGRAM

MARR ST. & RUTGERS ST. N. W.

SEC. MAP 227

DATE PAGE NO.

"IMPERIAL" TRACING CLOTH K & E CO., N. Y.