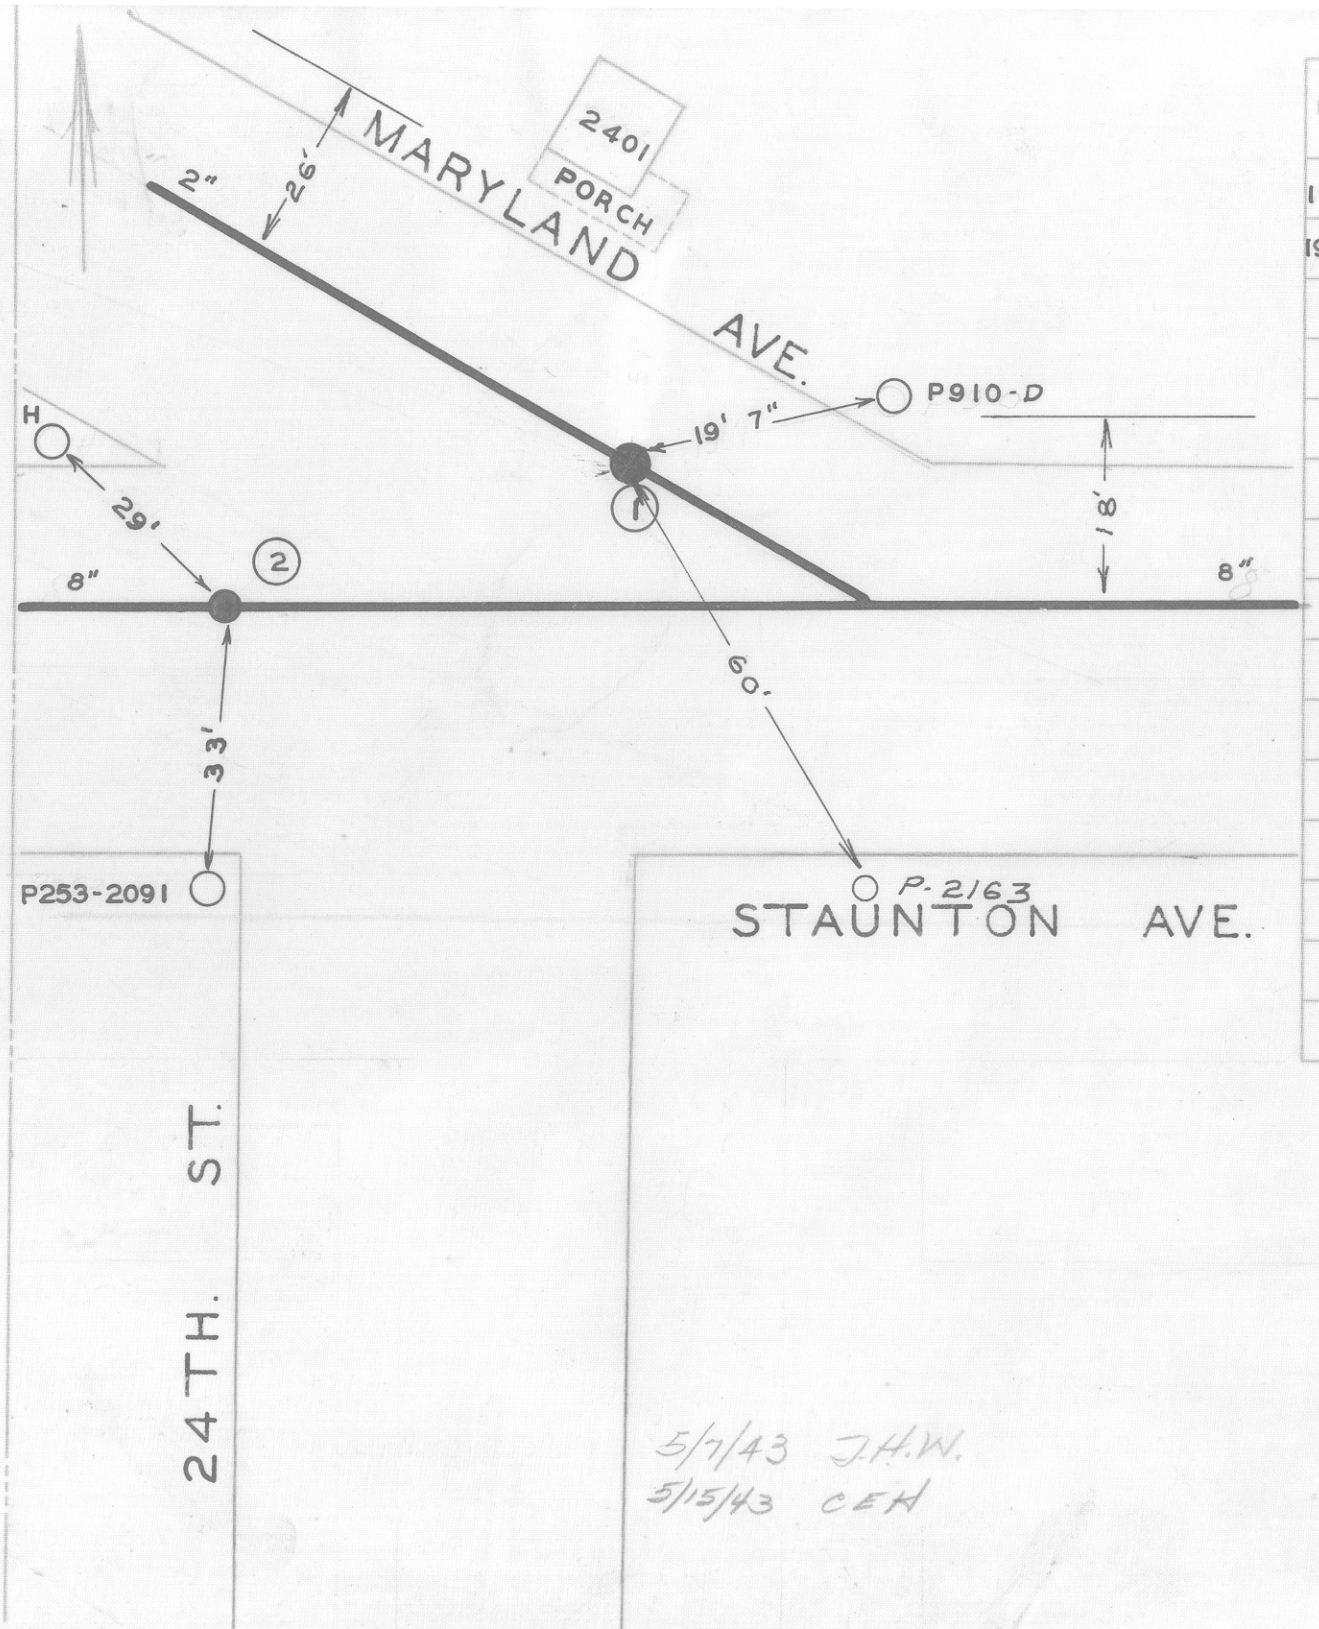

DATE	NO.	SIZE	MAKE	OPEN	TURNS
1928	1	2"		R	8
1942	2	8"		R	28
	1	81'-E	EPL	24TH. ST.	
	2	3'-W	WPL		

5/7/43 J.H.W.
5/15/43 CEH

CITY OF ROANOKE—WATER DEP'T
VALVE DIAGRAM
MARYLAND AVE. STAUNTON AVE. & 24TH. ST. N.W.

SEC. MAP 243

DATE PAGE NO. NW250