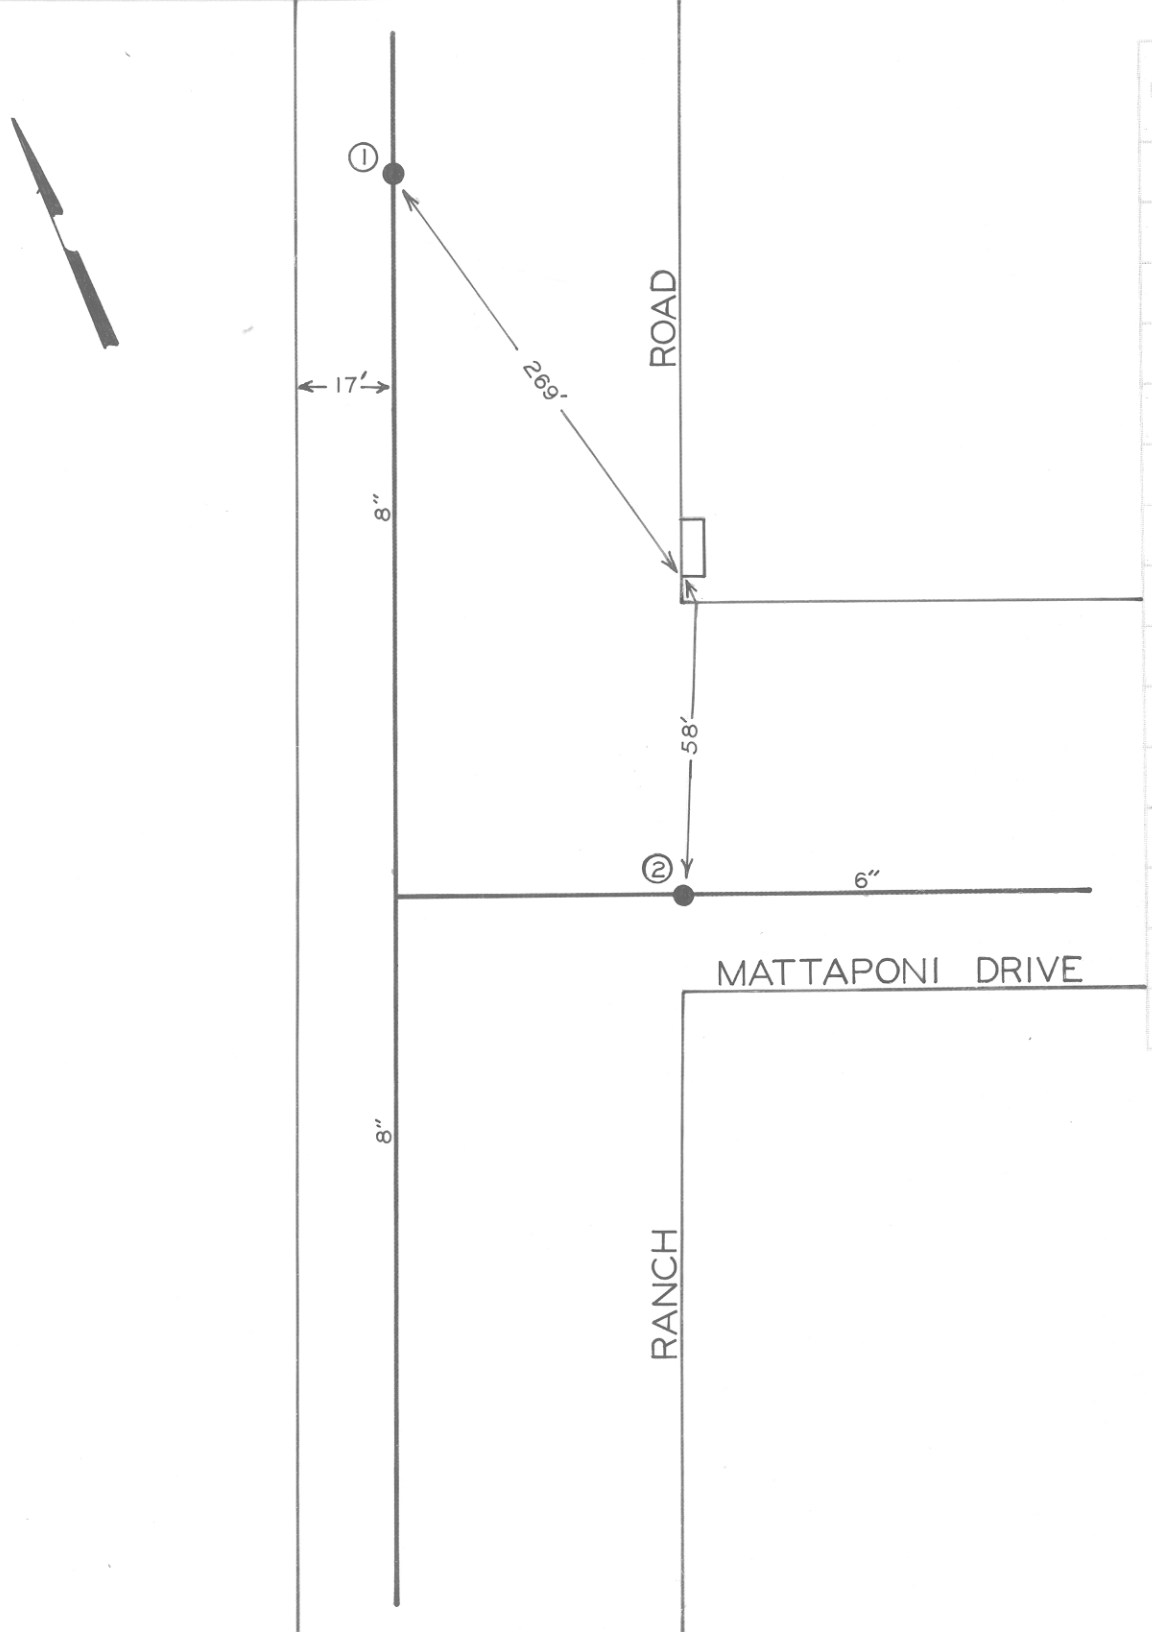

DATE	NO.	SIZE	MAKE	OPEN	TURNS
69	1	8"	MUELLER	R	27
69	2	6"	MUELLER	R	21
	1	297'	N. OF N.P.L.		

CITY OF ROANOKE — WATER DEP'T

VALVE DIAGRAM

MATTAPONI DR. & RANCH RD. N.W.

SEC. MAP 643 NW

DATE PAGE NO.