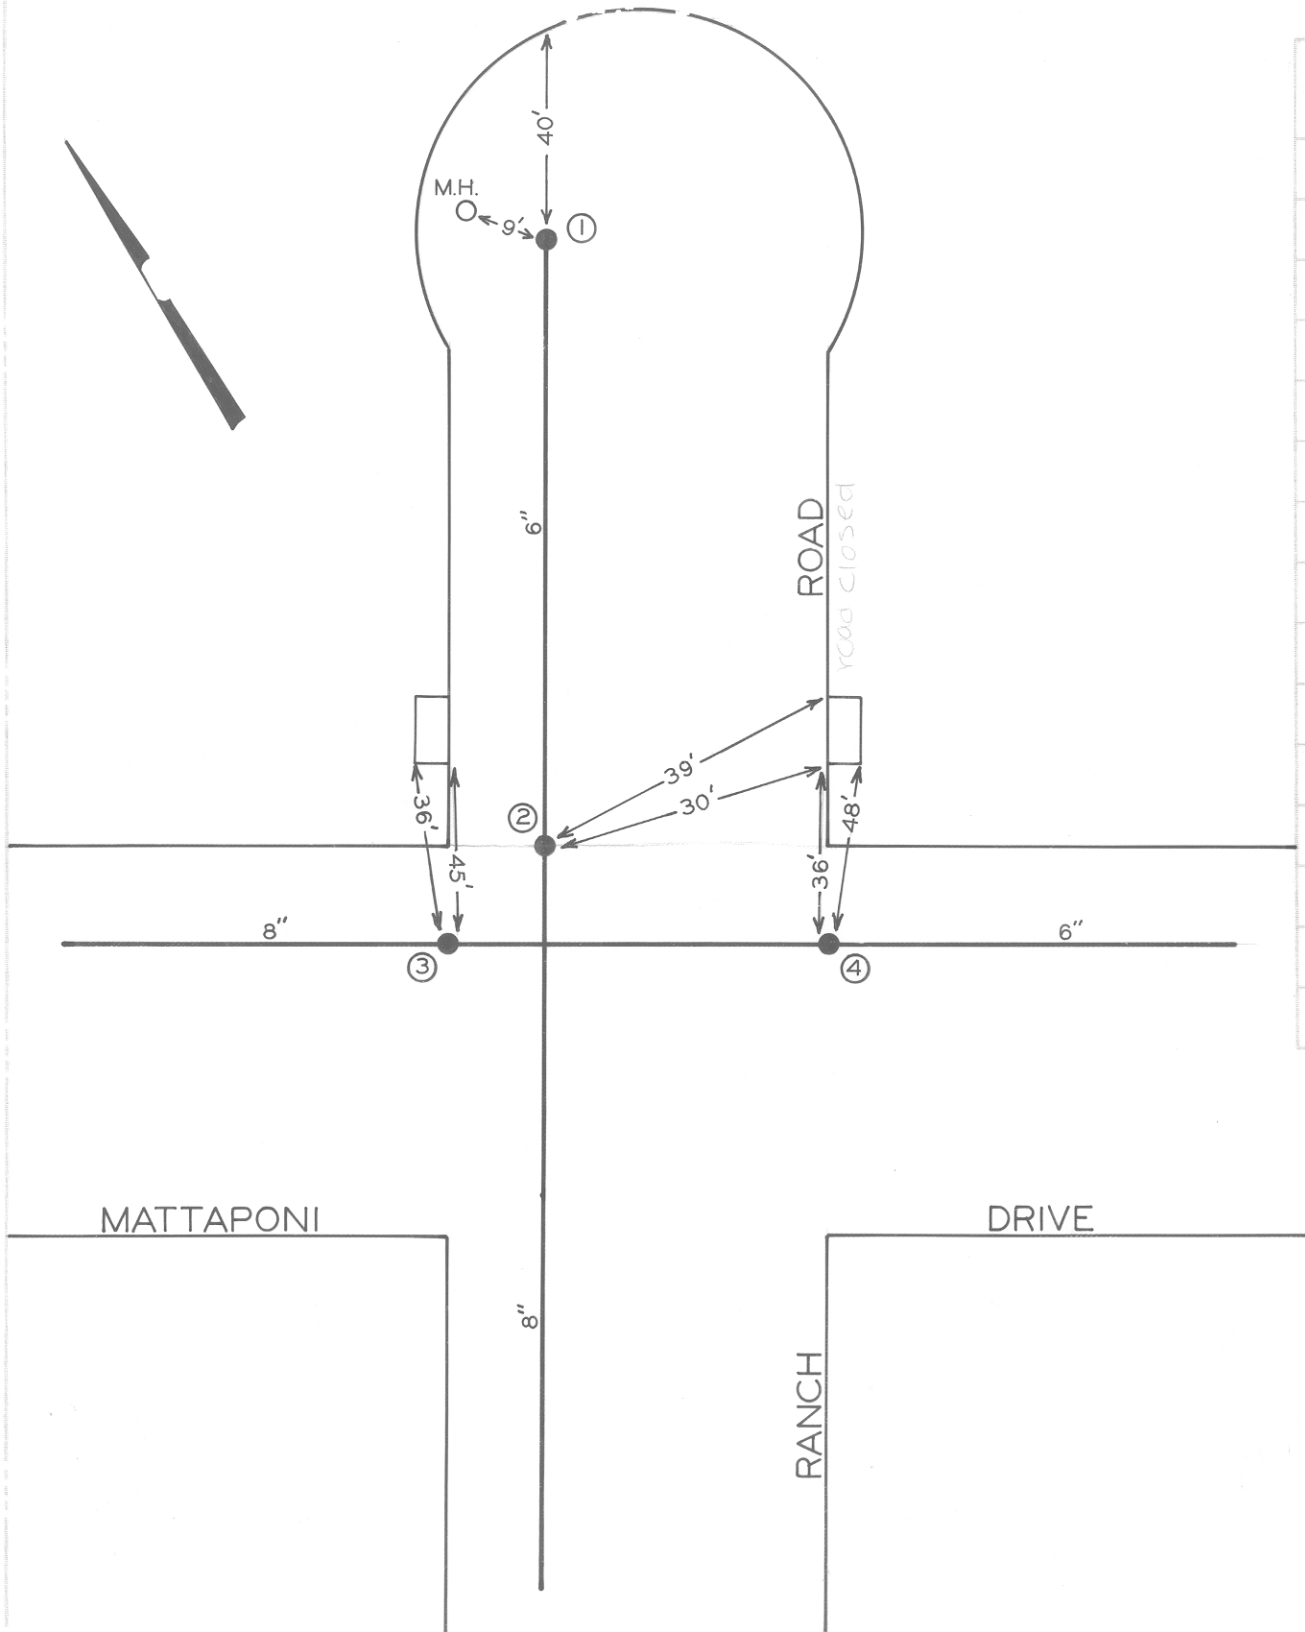

DATE	NO.	SIZE	MAKE	OPEN	TURNS
68	1	2"	MISC.	L	
68	2	8"	MUELLER	R	
68	3	8"	MUELLER	R	
68	4	6"	MUELLER	R	

CITY OF ROANOKE — WATER DEP'T

VALVE DIAGRAM

MATTAPONI DRIVE &

RANCH ROAD N.W.

SEC. MAP ~~74~~ 643

DATE PAGE NO.