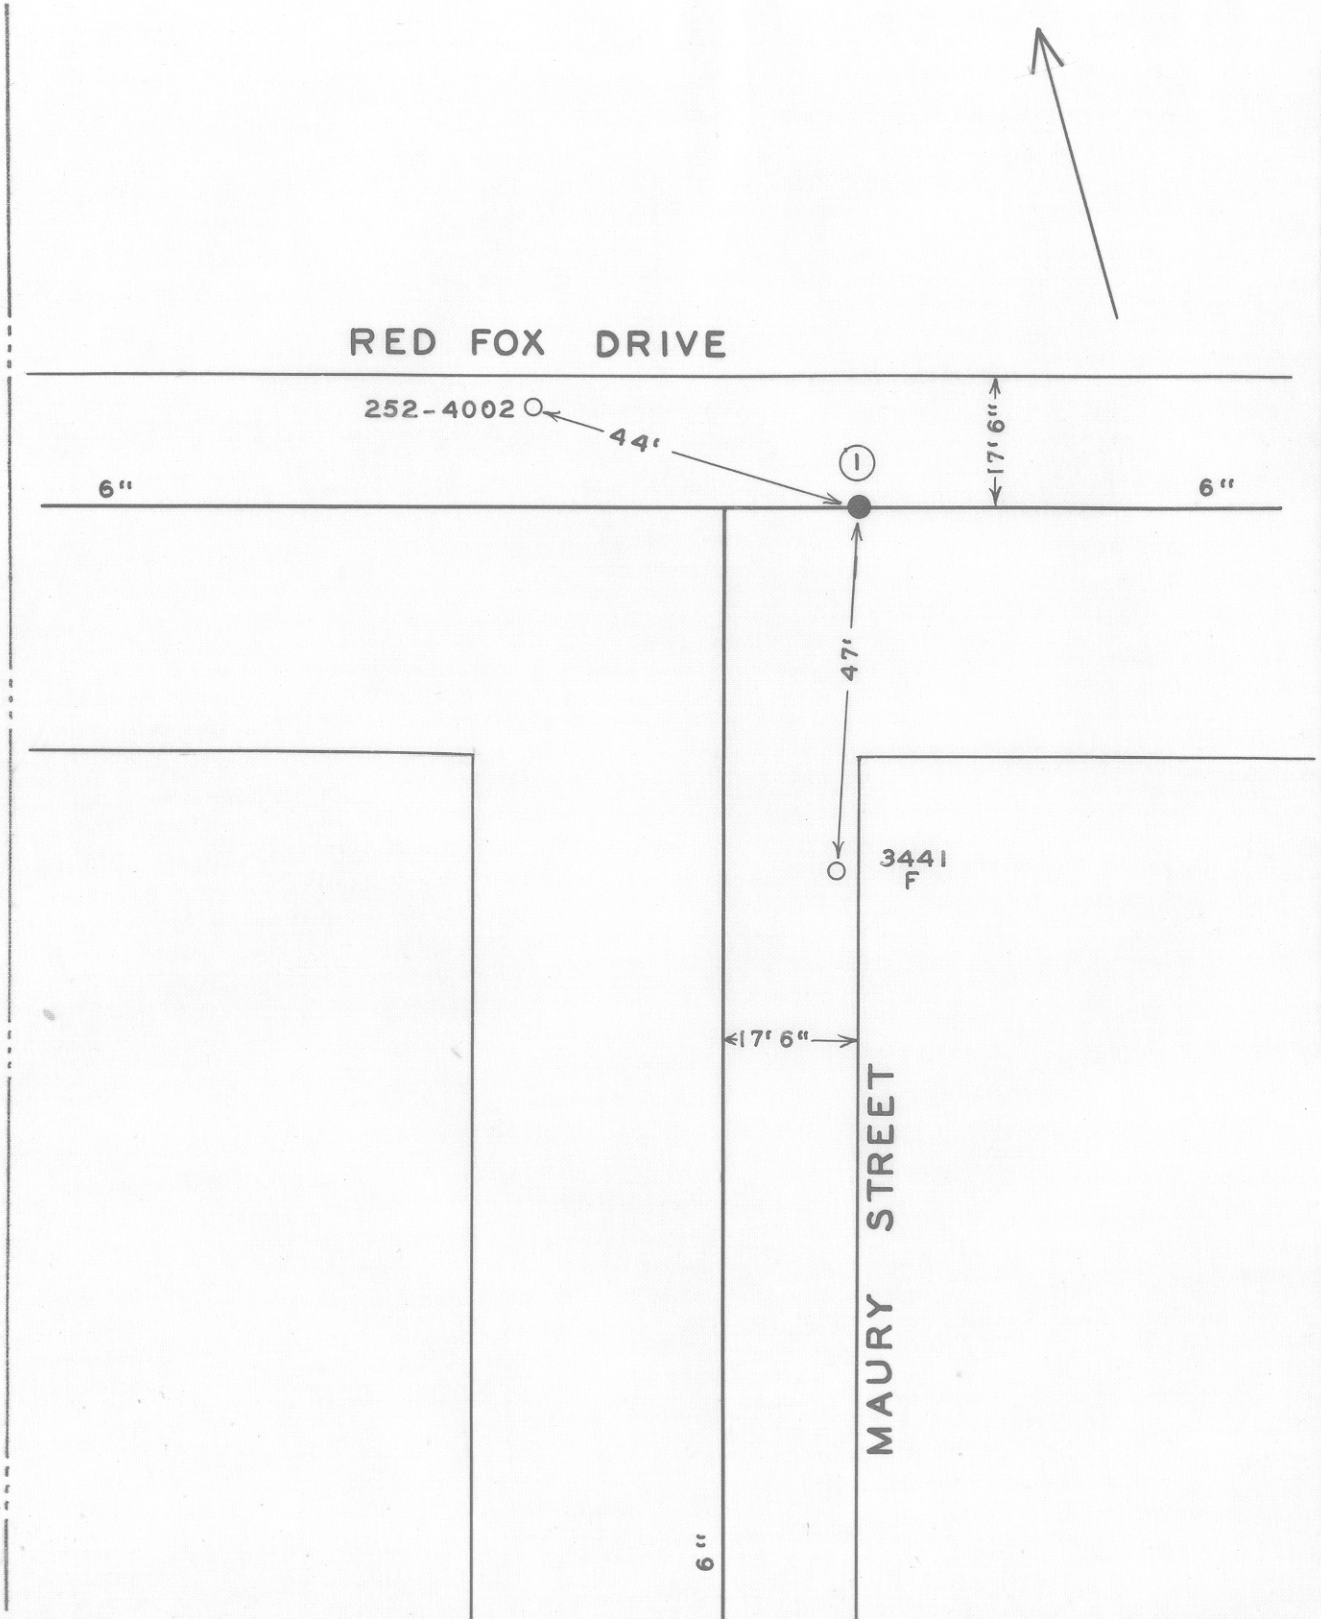

DATE	NO.	SIZE	MAKE	OPEN	TURNS
12-63	1	6"	MUELLER	R	21
	1	0	E.P.L.		

CITY OF ROANOKE—WATER DEPT.

VALVE DIAGRAM

MAURY STREET &

RED FOX DRIVE N.W.

SEC. MAP 274

DATE PAGE NO.