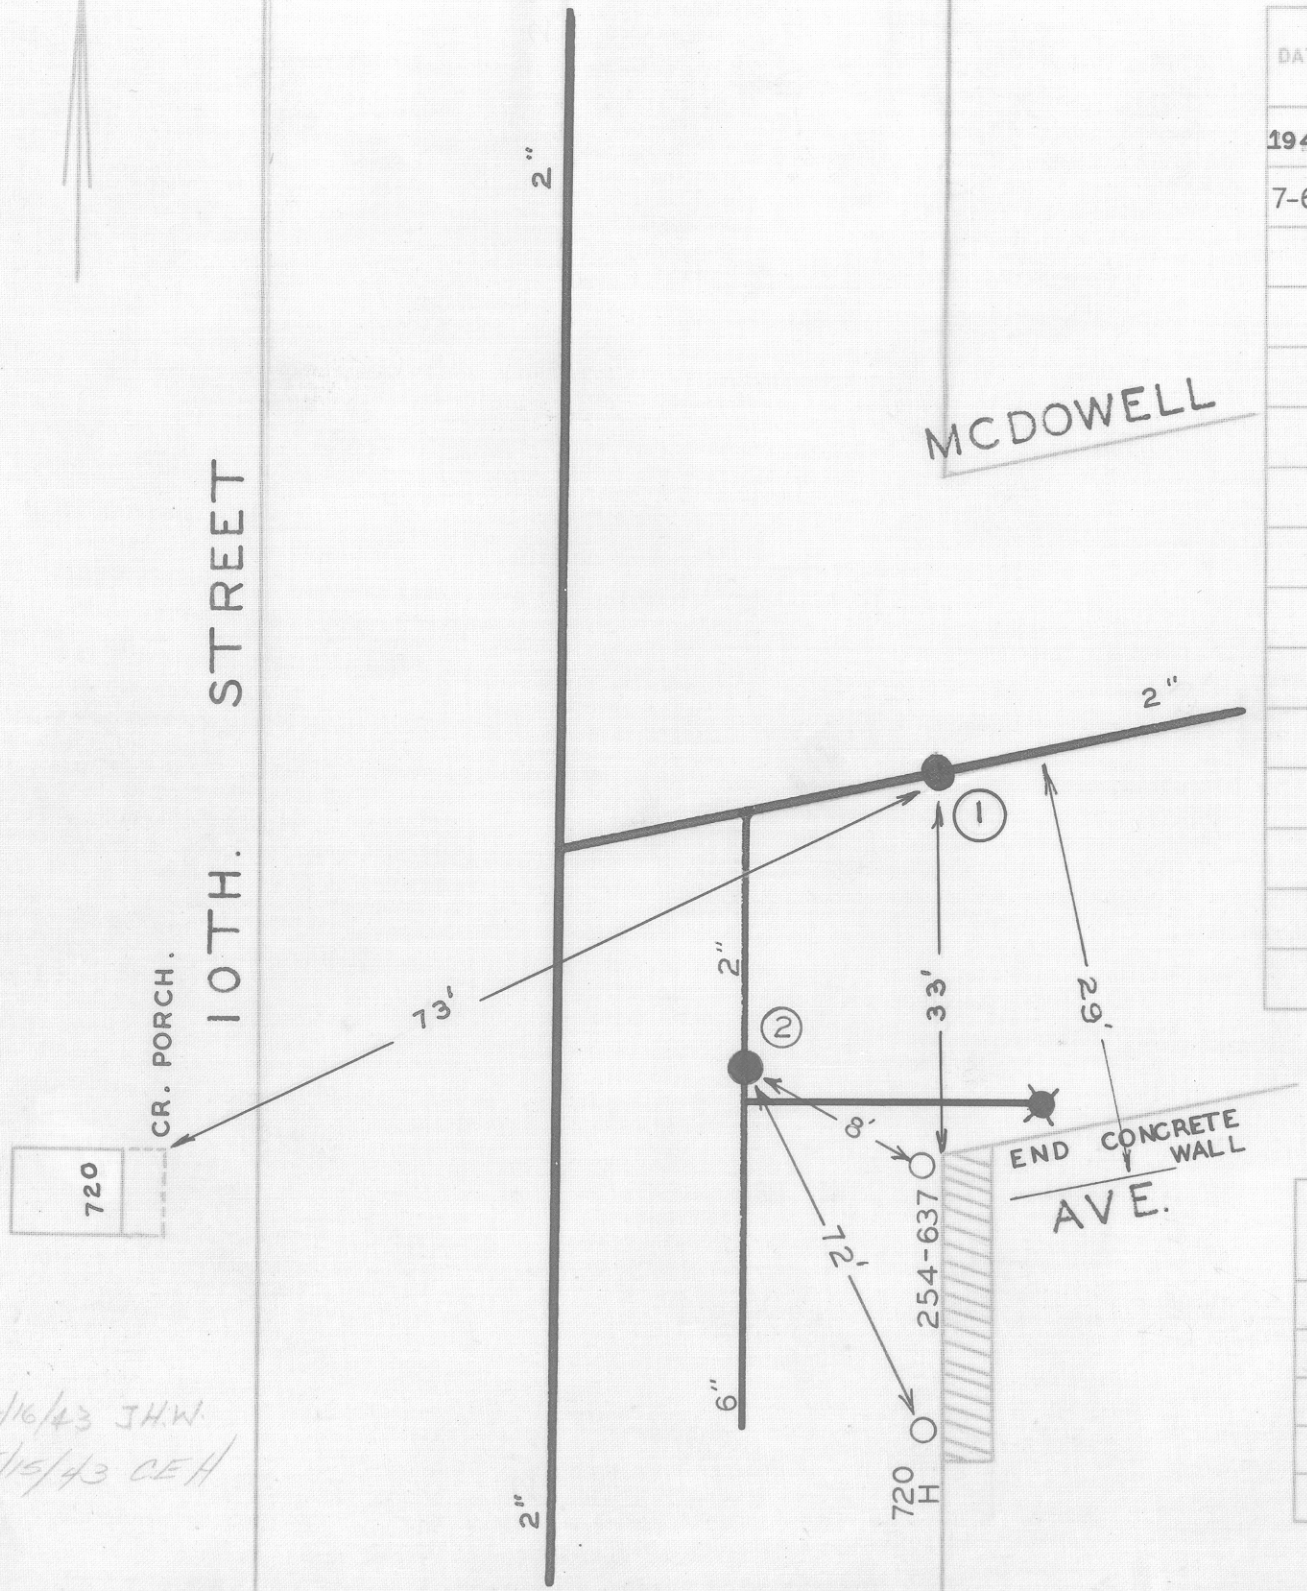

DATE	NO.	SIZE	MAKE	OPEN	TURNS
1949	1	2"	DARLING	R	7
7-68	2	2	DARLING	R	
	1	11'-W	EPL		
	2	10'-N	SPL		

CITY OF ROANOKE—WATER DEP'T

VALVE DIAGRAM

MCDOWELL

MC. DOWOWELL AVE &

10TH. ST N. W.

SEC. MAP 212

DATE PAGE NO. NW 111

4/16/43 J.H.W.

5/15/43 CEH