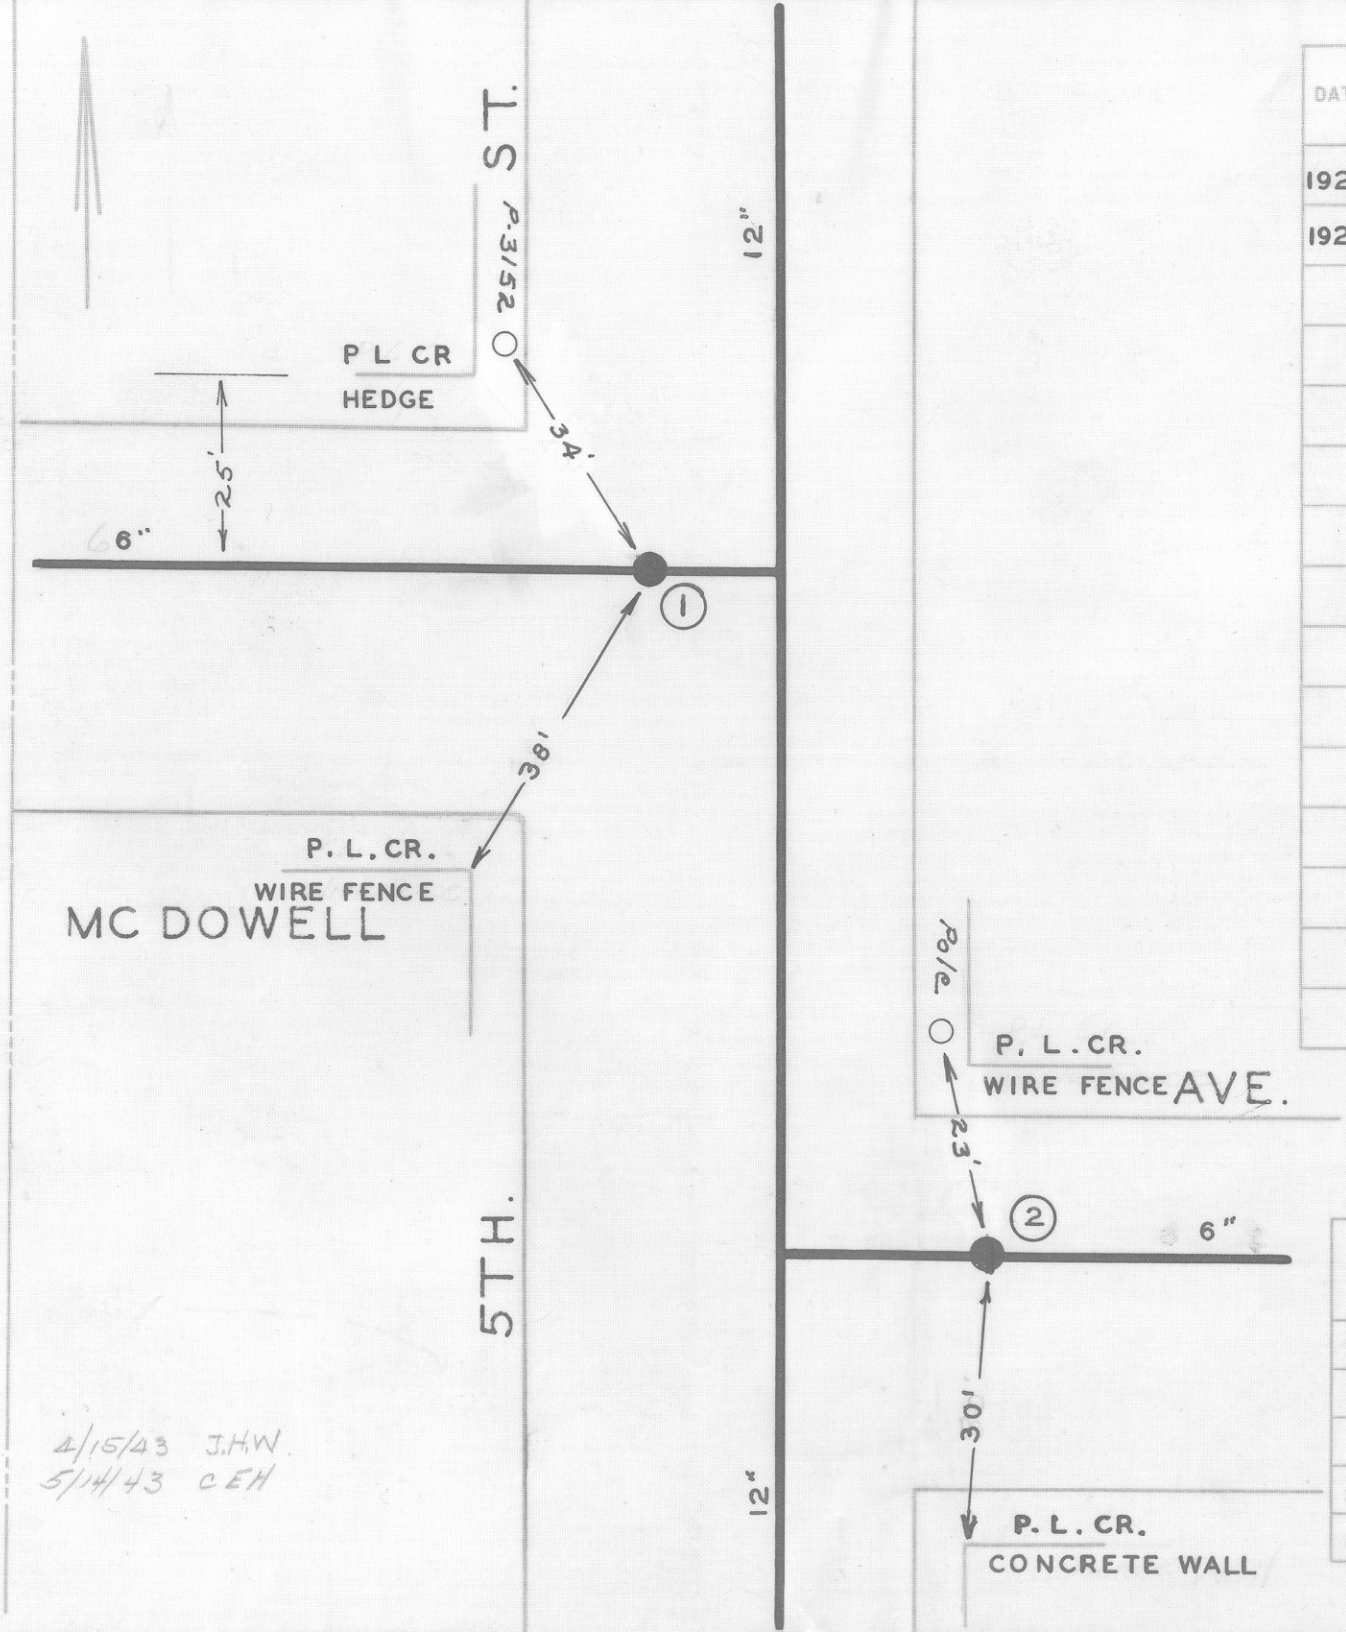

DATE	NO.	SIZE	MAKE	OPEN	TURNS
1925	1	6"		R	20 1/2
1927	2	6"		R	20 1/2
	1	31'-E	WPL		
	2	0	EPL		

CITY OF ROANOKE—WATER DEP'T

VALVE DIAGRAM

MC-DOWELL AVE. & 5TH. ST. N.W.

SEC. MAP 202

DATE

PAGE NO. N.W.42