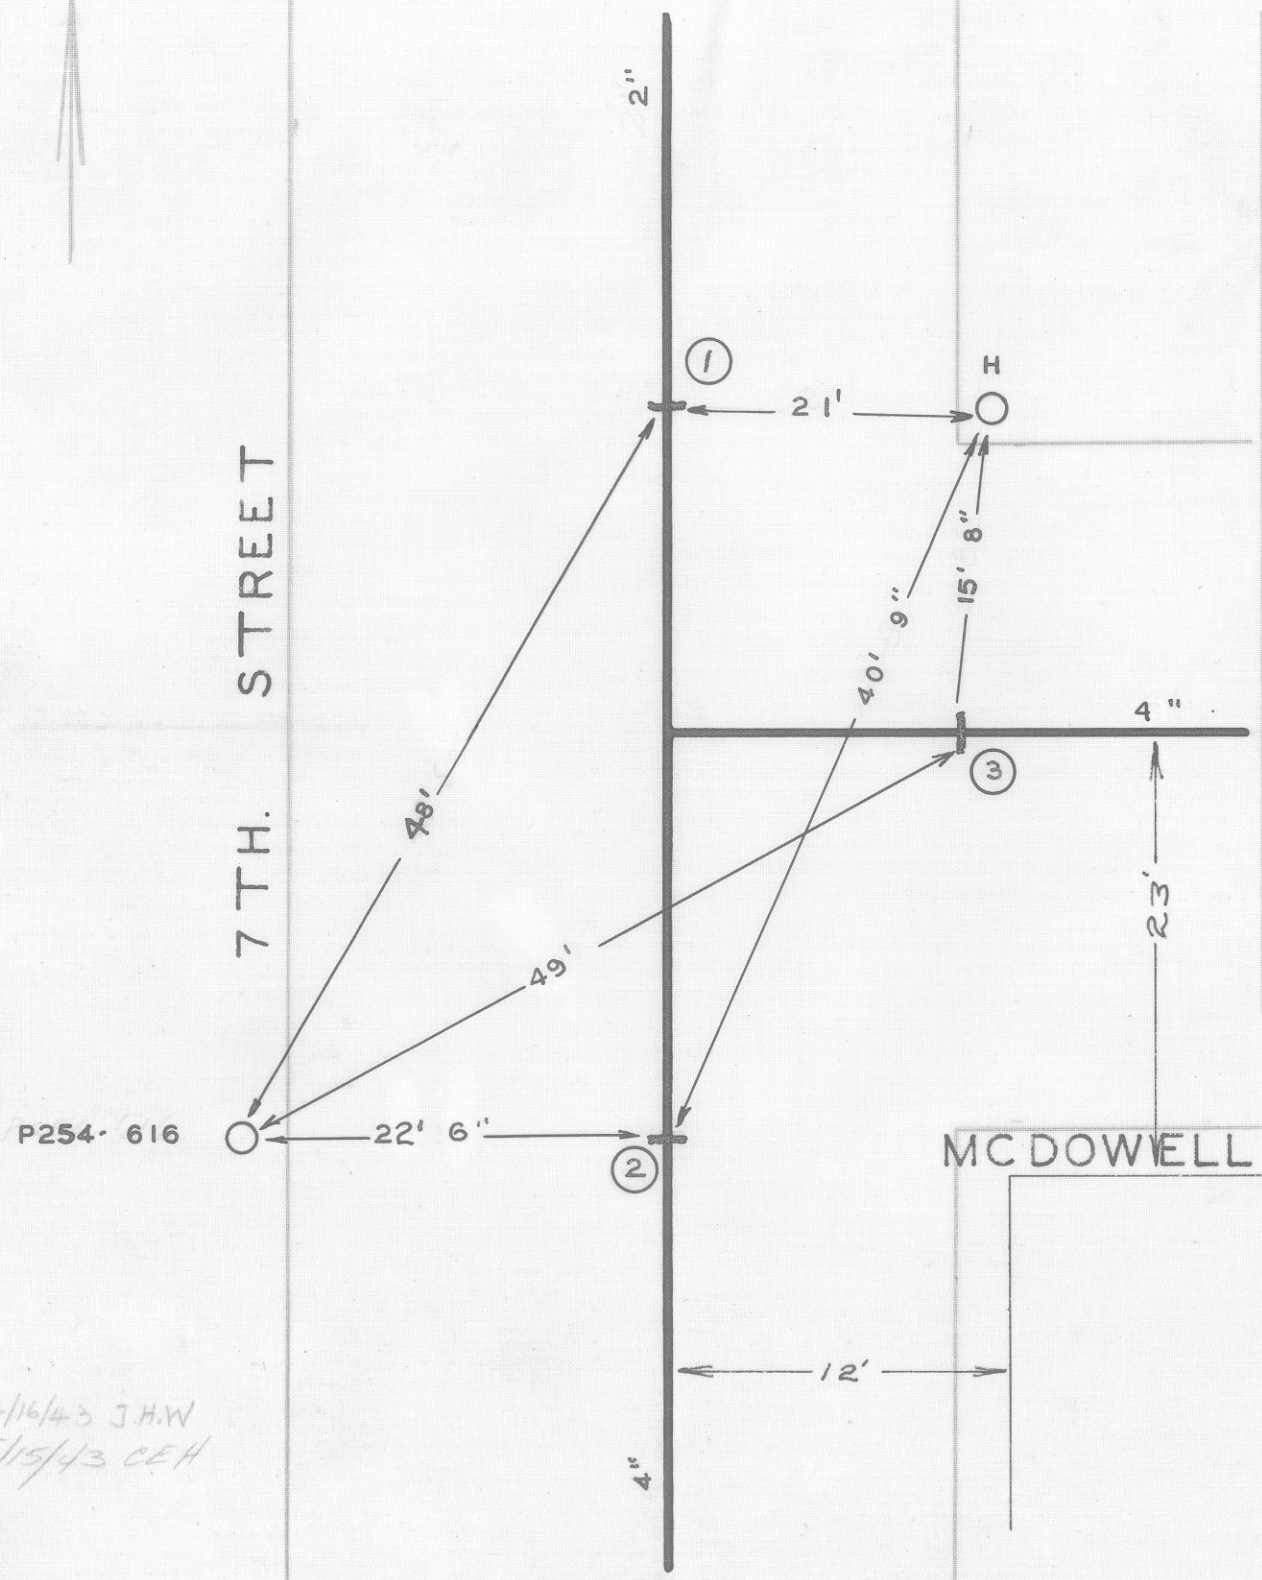

DATE	NO.	SIZE	MAKE	OPEN	TURNS
1925	1	2"		L	9
1890	2	4"		R	20.
1890	3	4"		R	21
	1	0	NPL		
	2	6'-N	SPL		
	3	10'-E	EPL		

4/16/43 J.H.W
5/15/43 CEH

CITY OF ROANOKE—WATER DEP'T

VALVE DIAGRAM

MC. DOWELL AVE. & 7TH. ST. N. W.

SEC. MAP 212

DATE

PAGE NO NW 109