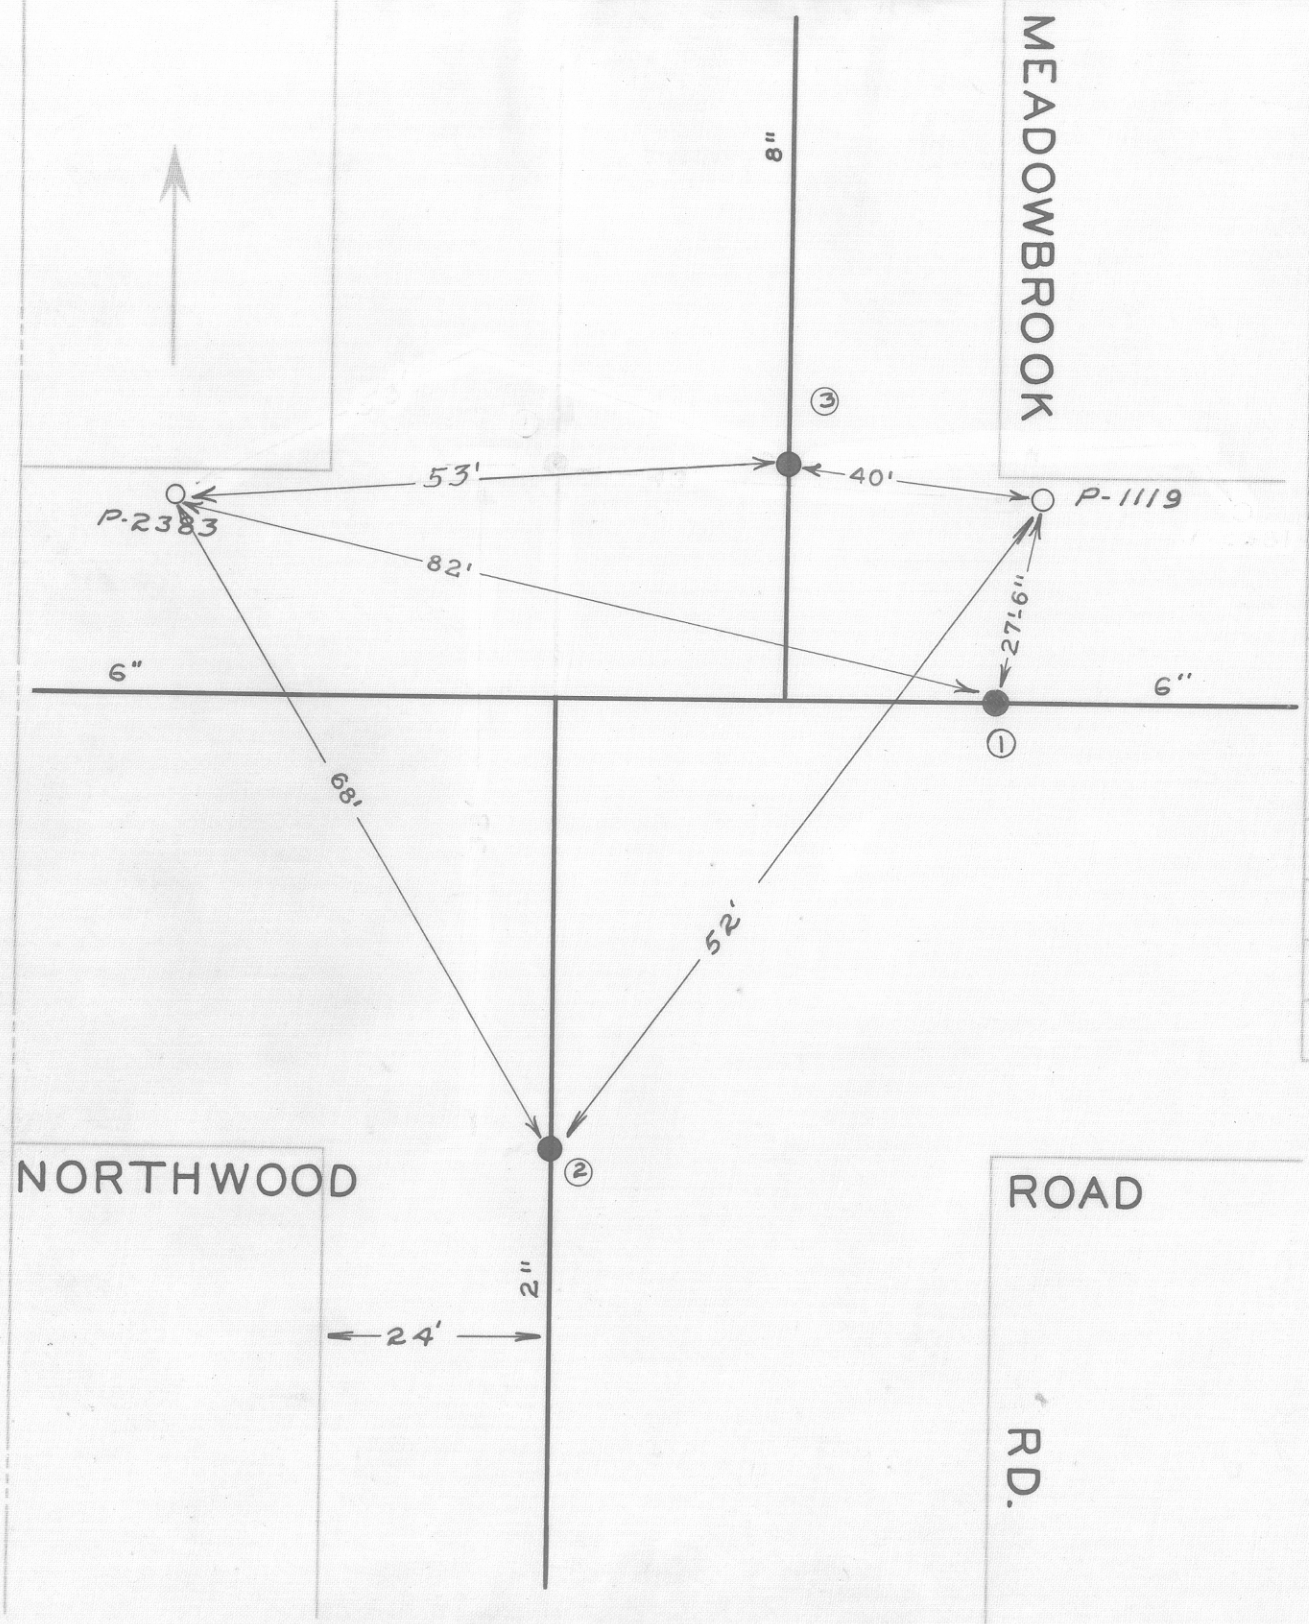

DATE	NO.	SIZE	MAKE	OPEN	TURNS
5-62	1	6"	DARLING	R	20
	2	2"			
	3	8"	MUELLER	R	27
	1	0	E.P.L.		
	2	0	SPL		
	3	0	NPL		

CITY OF ROANOKE—WATER DEP'T

VALVE DIAGRAM

MEADOWBROOK RD. &

NORTHWOOD RD. N.W.

SEC. MAP 614

DATE PAGE NO.