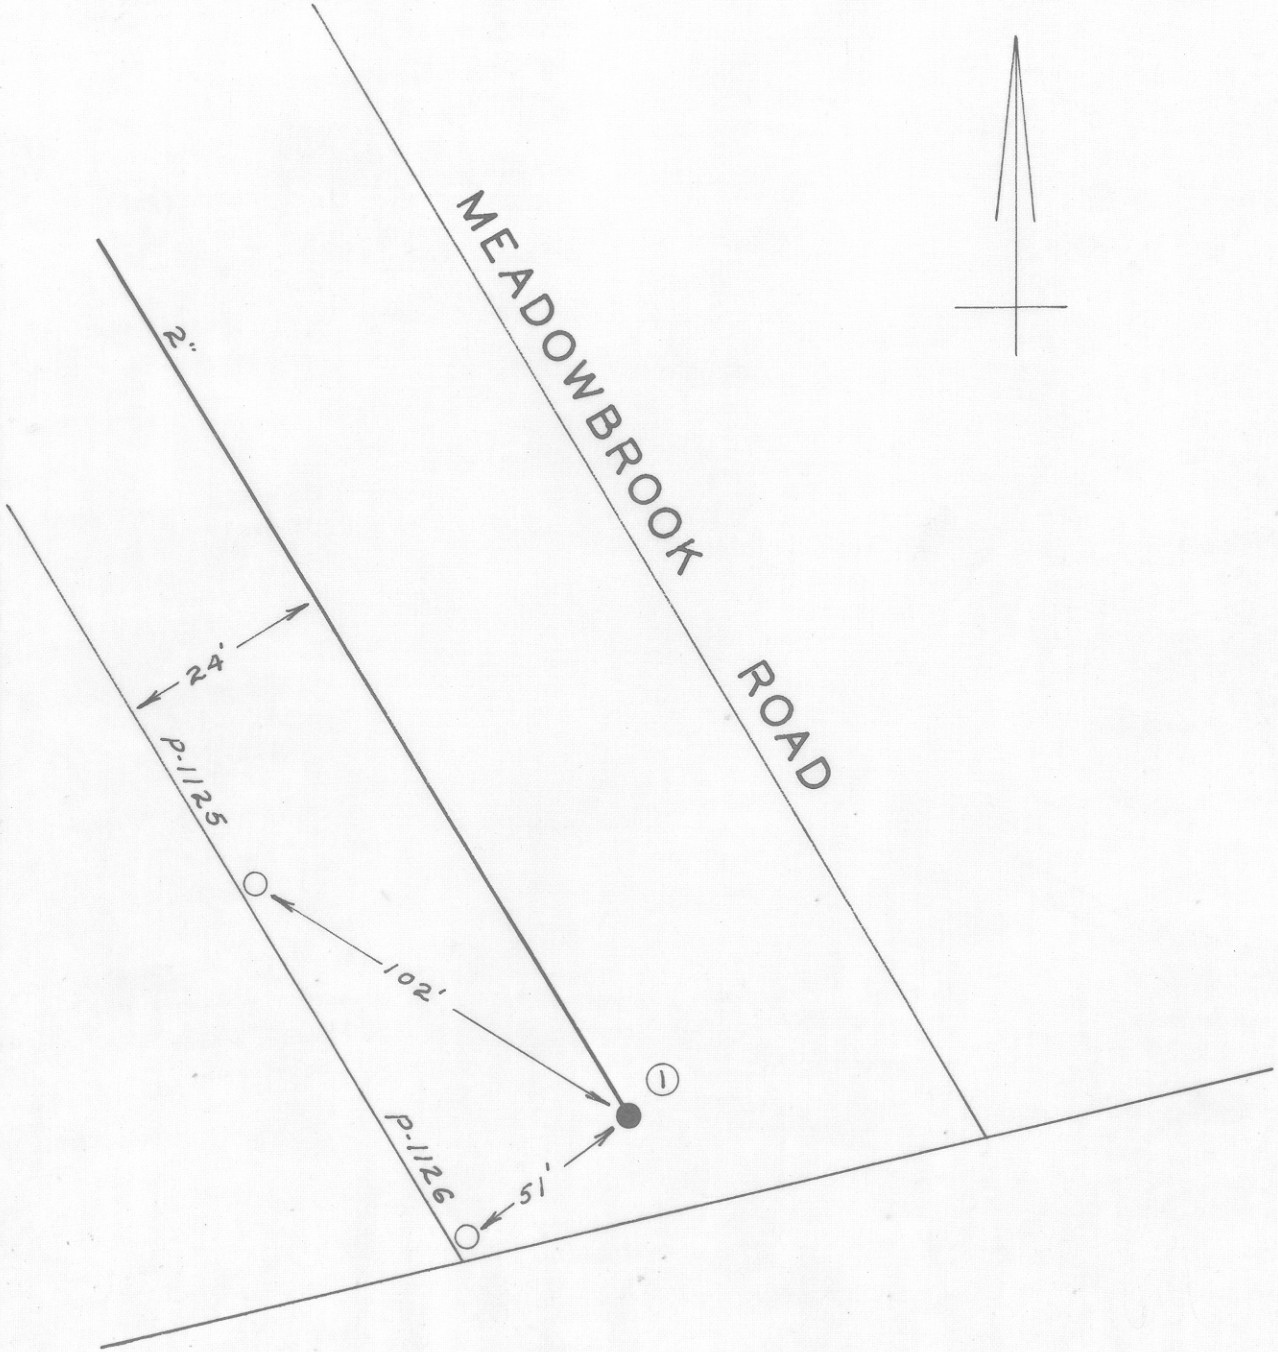

DATE	NO.	SIZE	MAKE	OPEN	TURNS
	1	2"			
	1	525'-S	SPL		

CITY OF ROANOKE — WATER DEPT.

VALVE DIAGRAM

MEADOWBROOK RD. 525'-S.

OF NORTHWOOD DR. N.W.

SEC. MAP 614

DATE PAGE NO.

"IMPERIAL" TRACING CLOTH
K & E CO., N. Y.