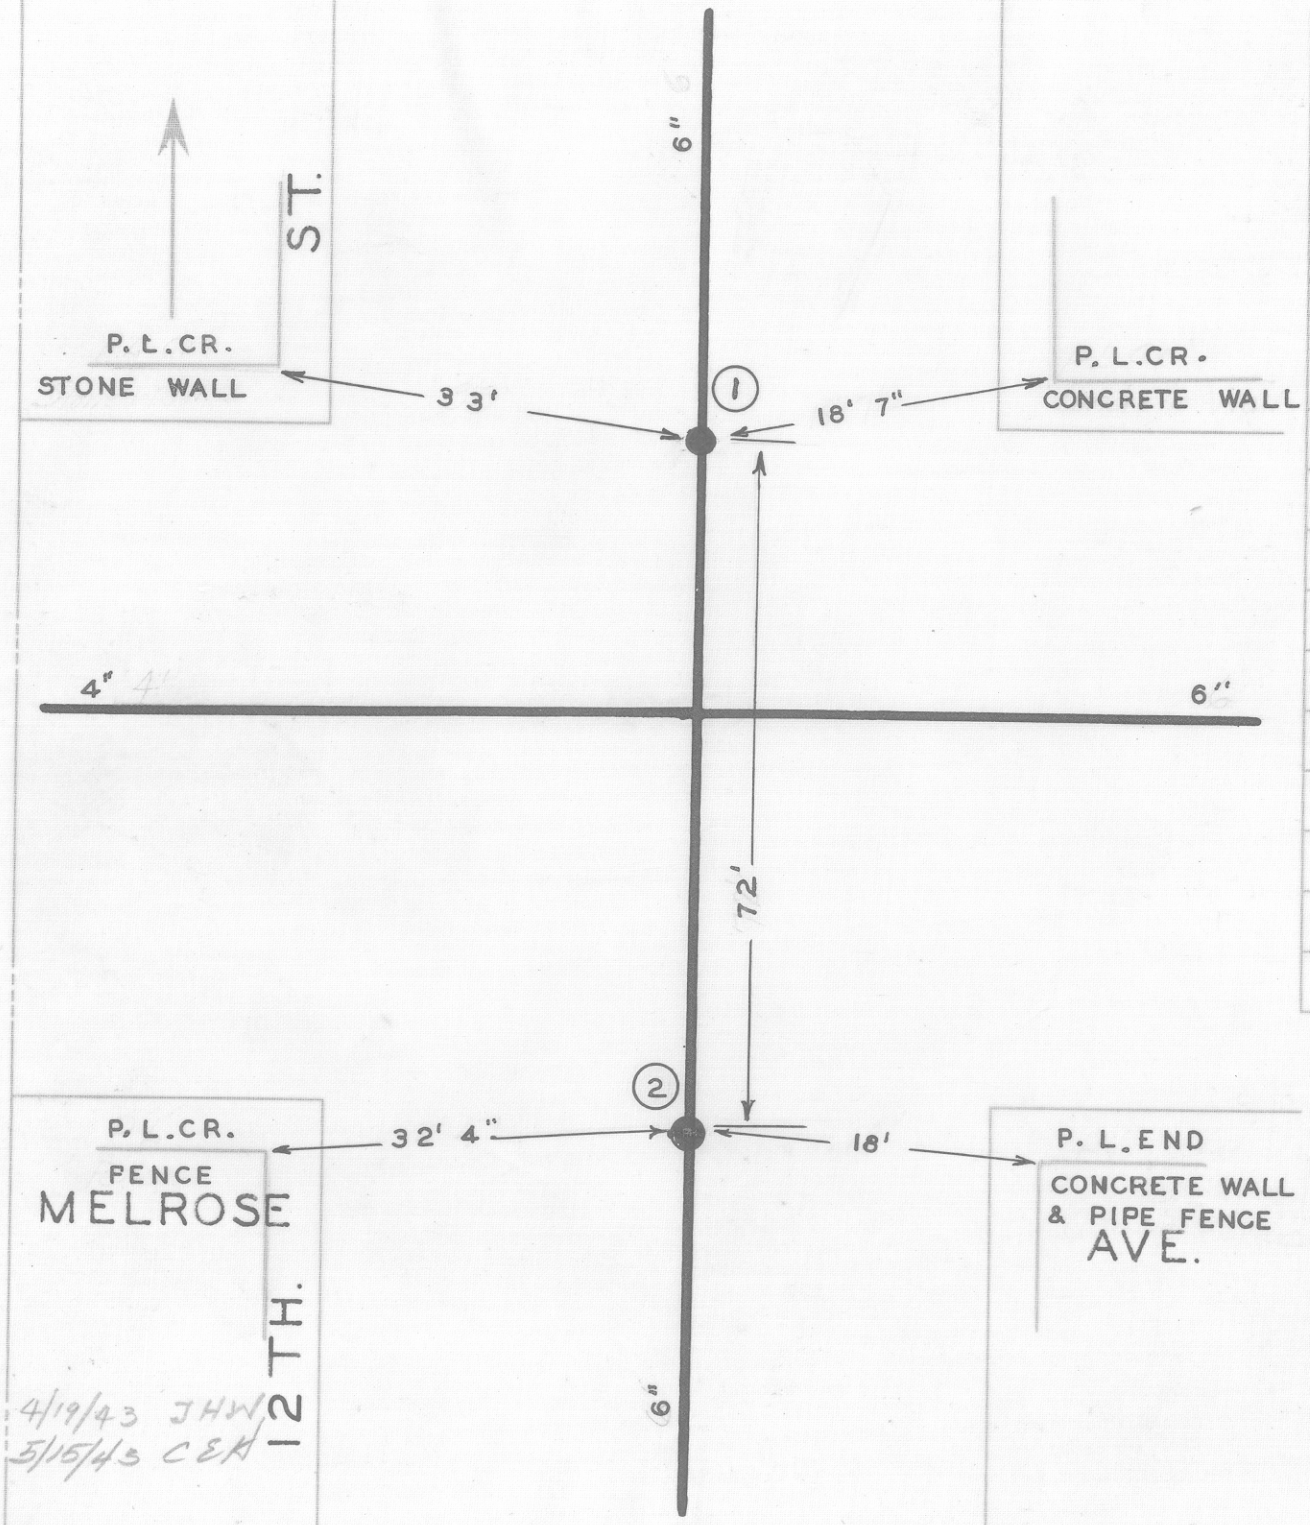

DATE	NO.	SIZE	MAKE	OPEN	TURNS
1891	1	6"		R	20 1/2
1891	2	6"		R	22
	1	7'-S	NPL		
	2	0	SPL		

CITY OF ROANOKE—WATER DEP'T

VALVE DIAGRAM

MELROSE AVE. & 12TH. ST. N. W.

SEC. MAP 222

DATE

PAGE NO. NW 140